


T. 4 S. R. 4 W. W.M.

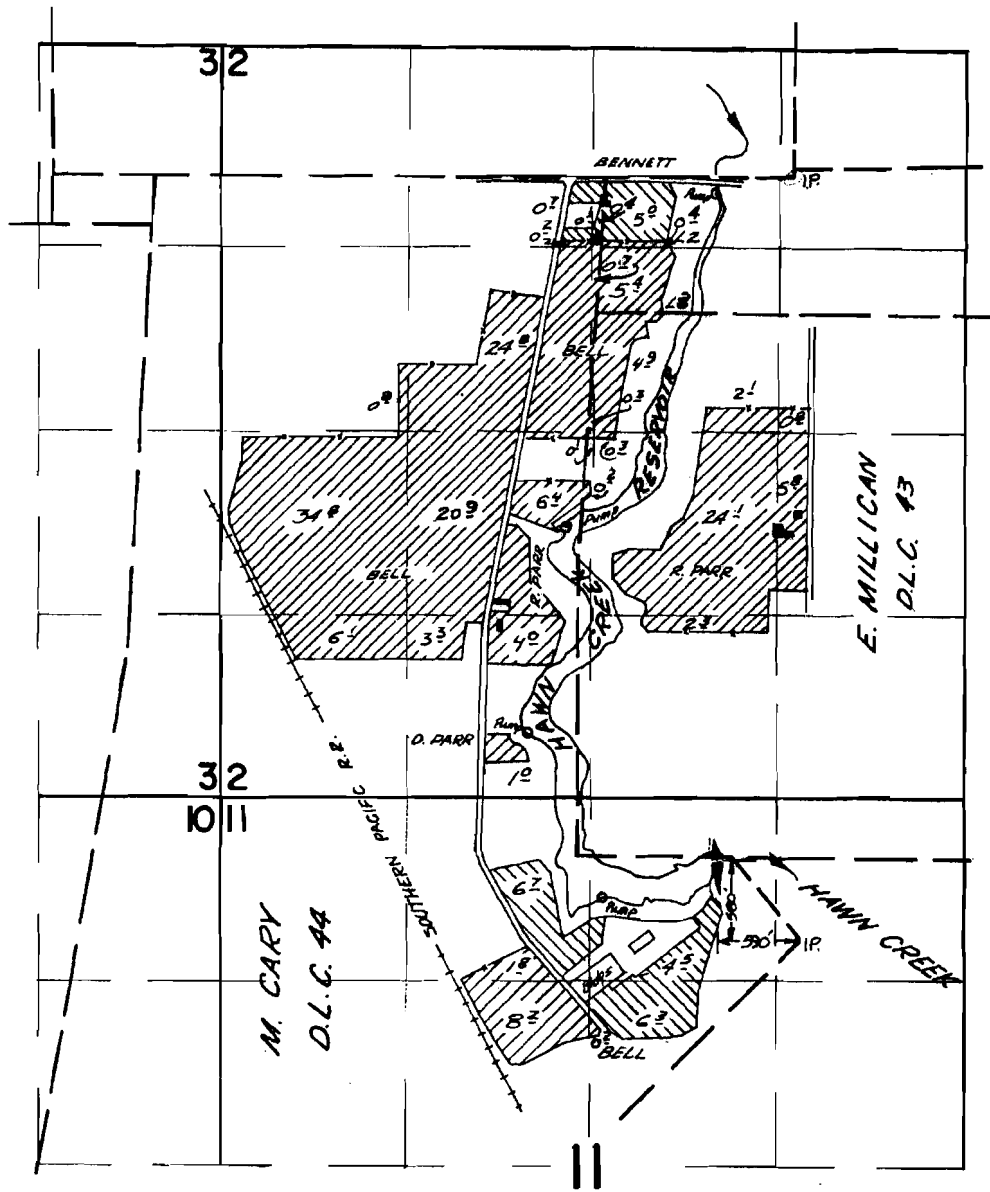

FINAL PROOF SURVEY

UNDER

Supp.
 Primary

R 34388

R 2570

Application No. ~~34389~~ Permit No. 27097

IN NAME OF

HAWIN CREEK DIST. IMPROVEMENT CO.

Surveyed April 12, 1967, by V. GARNER.....