


T.39S. R.5 W.W.M.

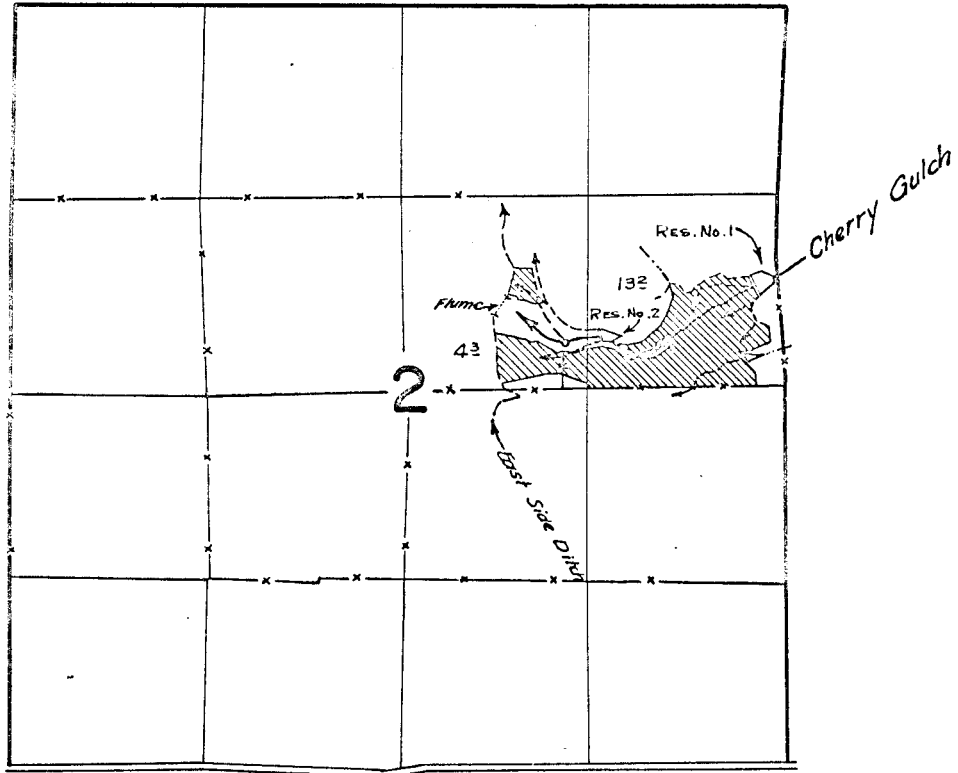

FINAL PROOF SURVEY UNDER

R-37254

R-2864

Application No. 37255... Permit No. 27926...

IN NAME OF

CLAIRE O. BROWN

Surveyed July 1, 1965, by *R. J. Pearson*