


R3150

T.40S.R.8E9W.W.M.

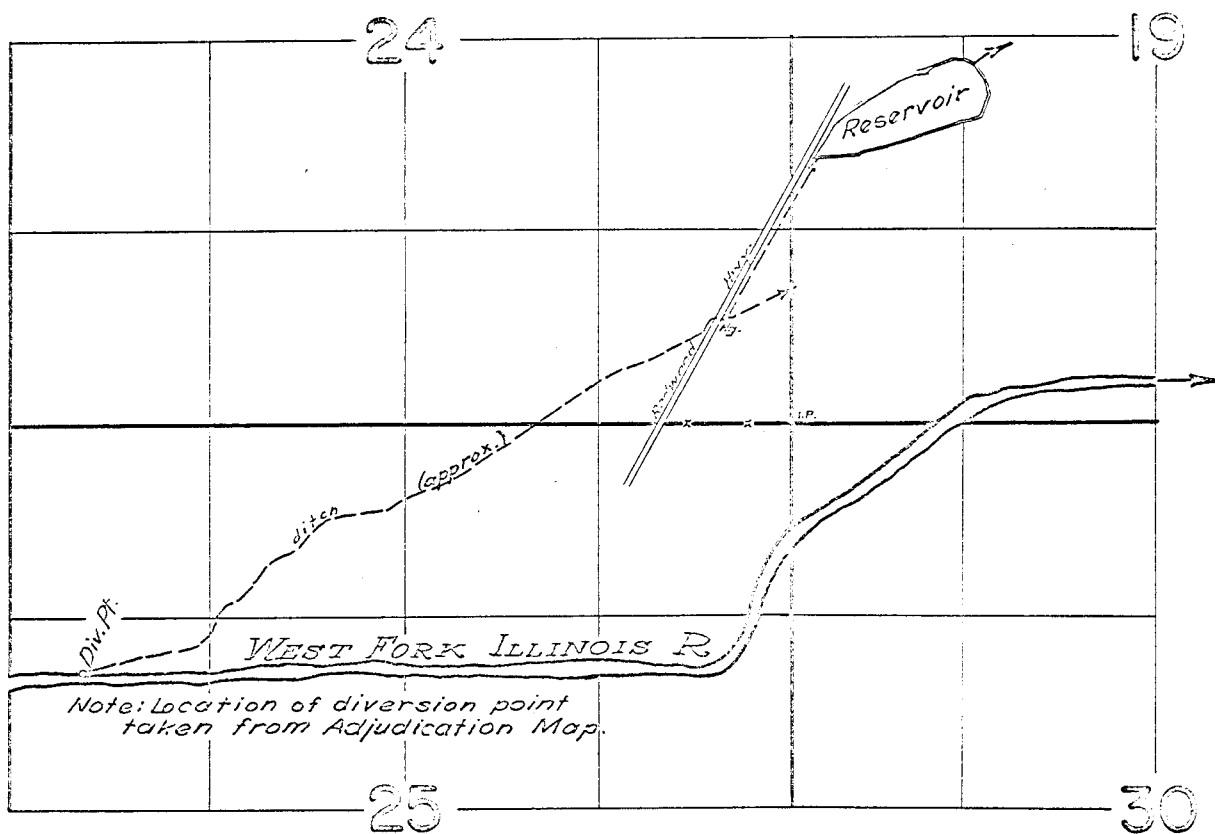

FINAL PROOF SURVEY
UNDER

R-37005 R-3150
Application No. 37260 Permit No. 20355
IN NAME OF

DELBERT O'BRIEN & CHARLIE A. TREFETHEN

Surveyed July 13, 1963, by *R. Johnson*