

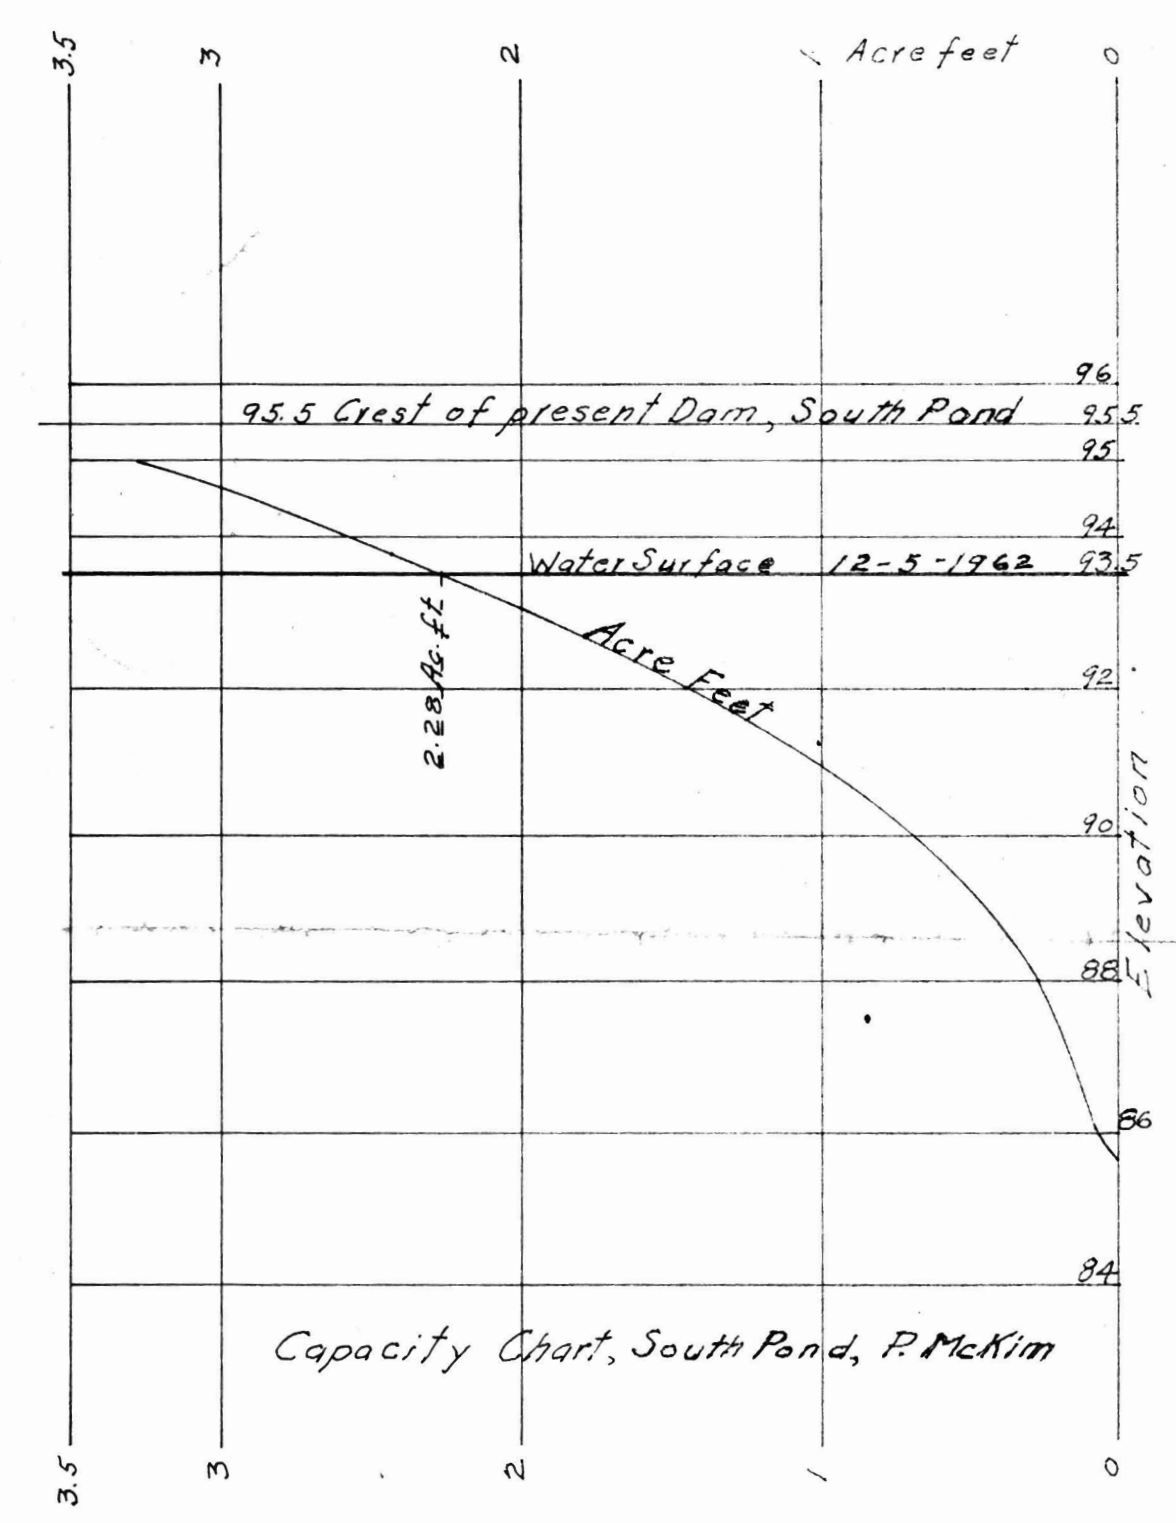
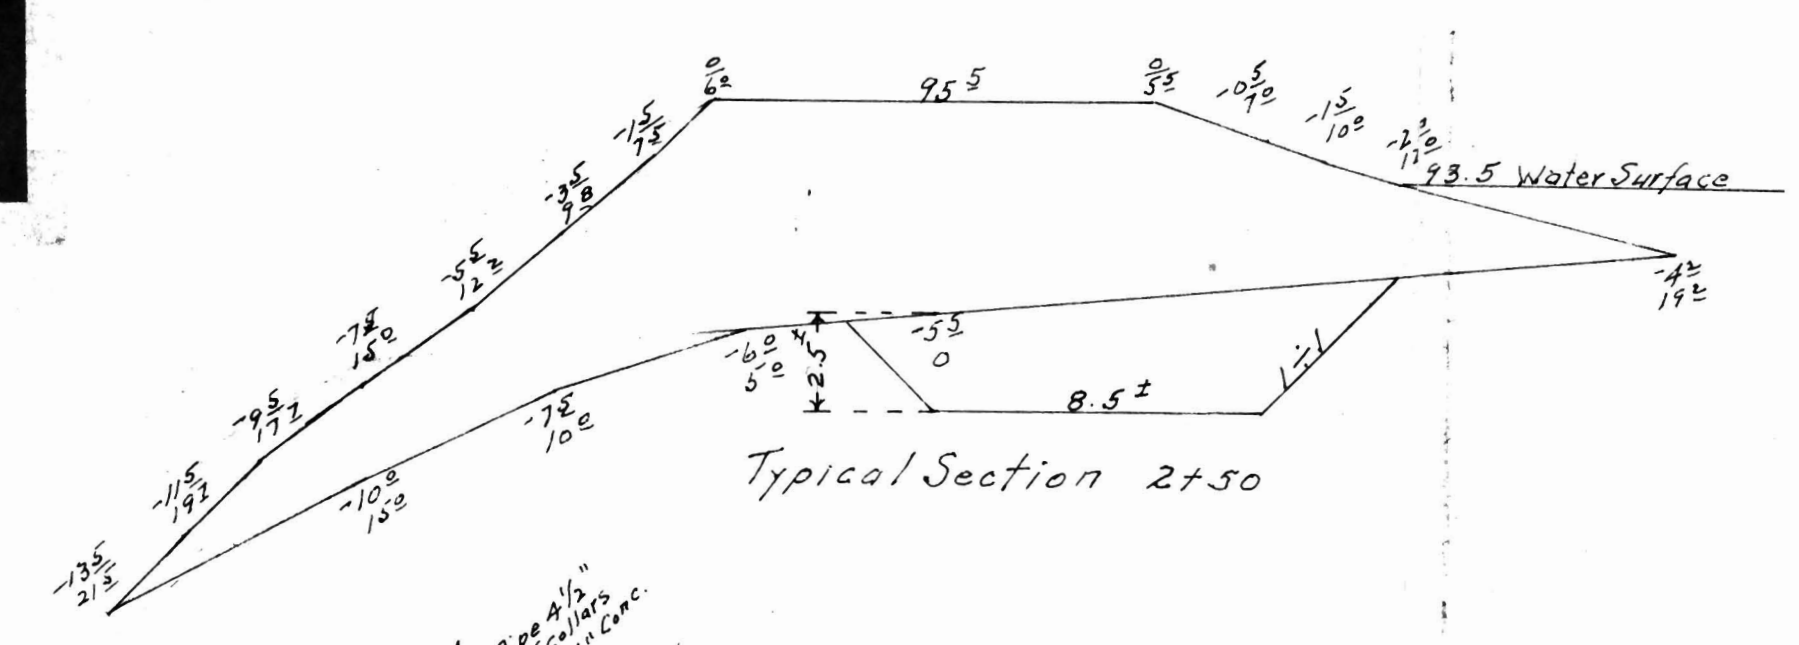


Capacity Chart, North Pond  
Note: 325,850 gal's. per. Ac. Ft.

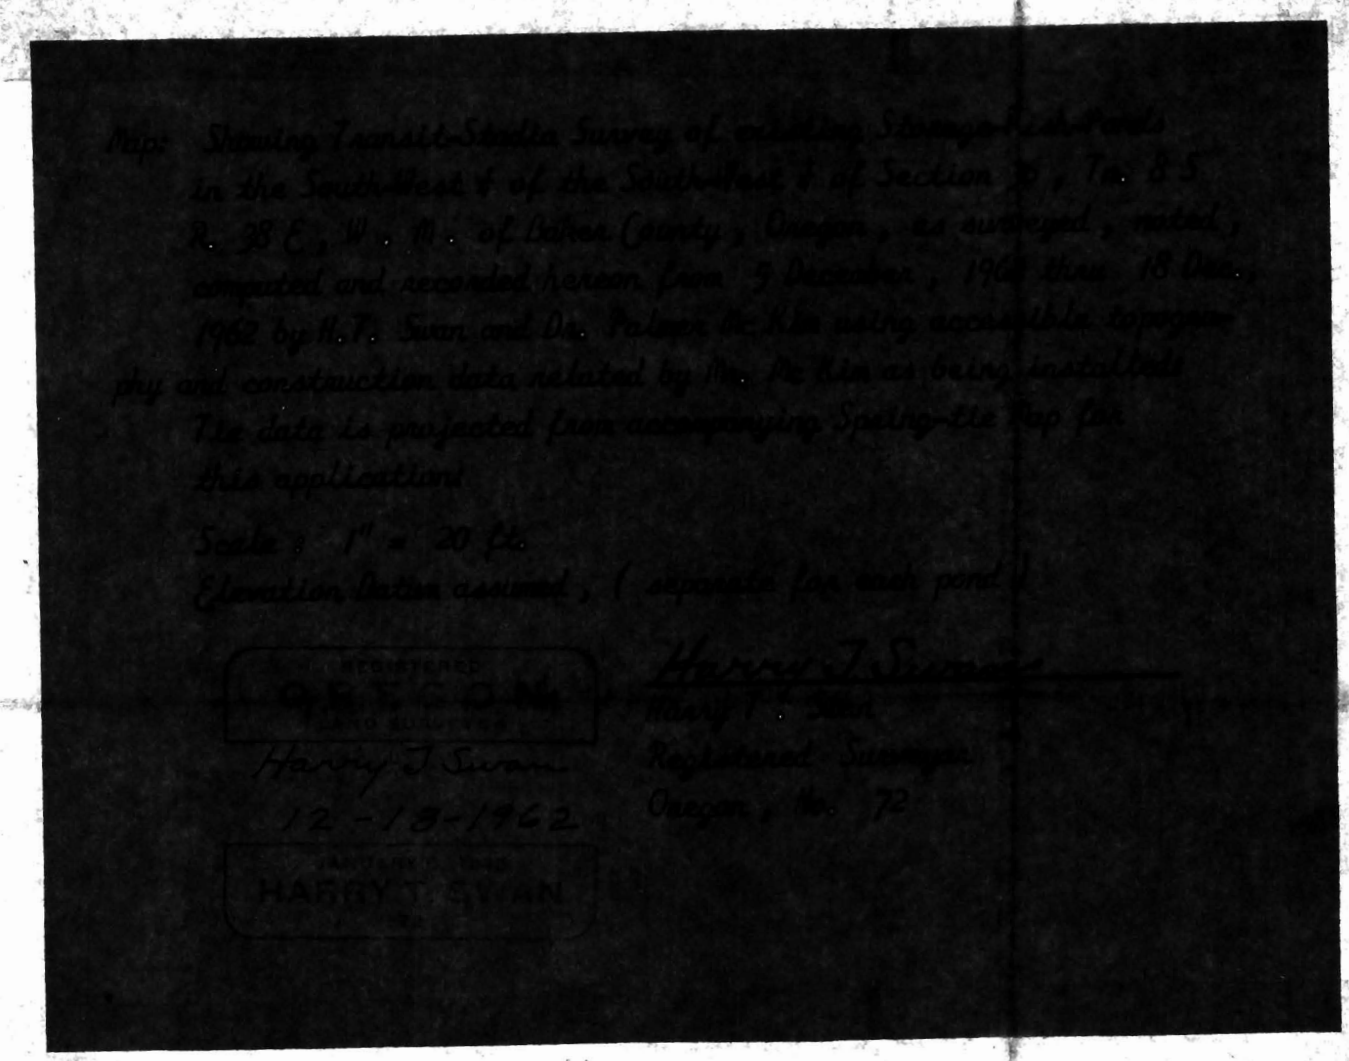

Capacity Chart, South Pond, P. McKim

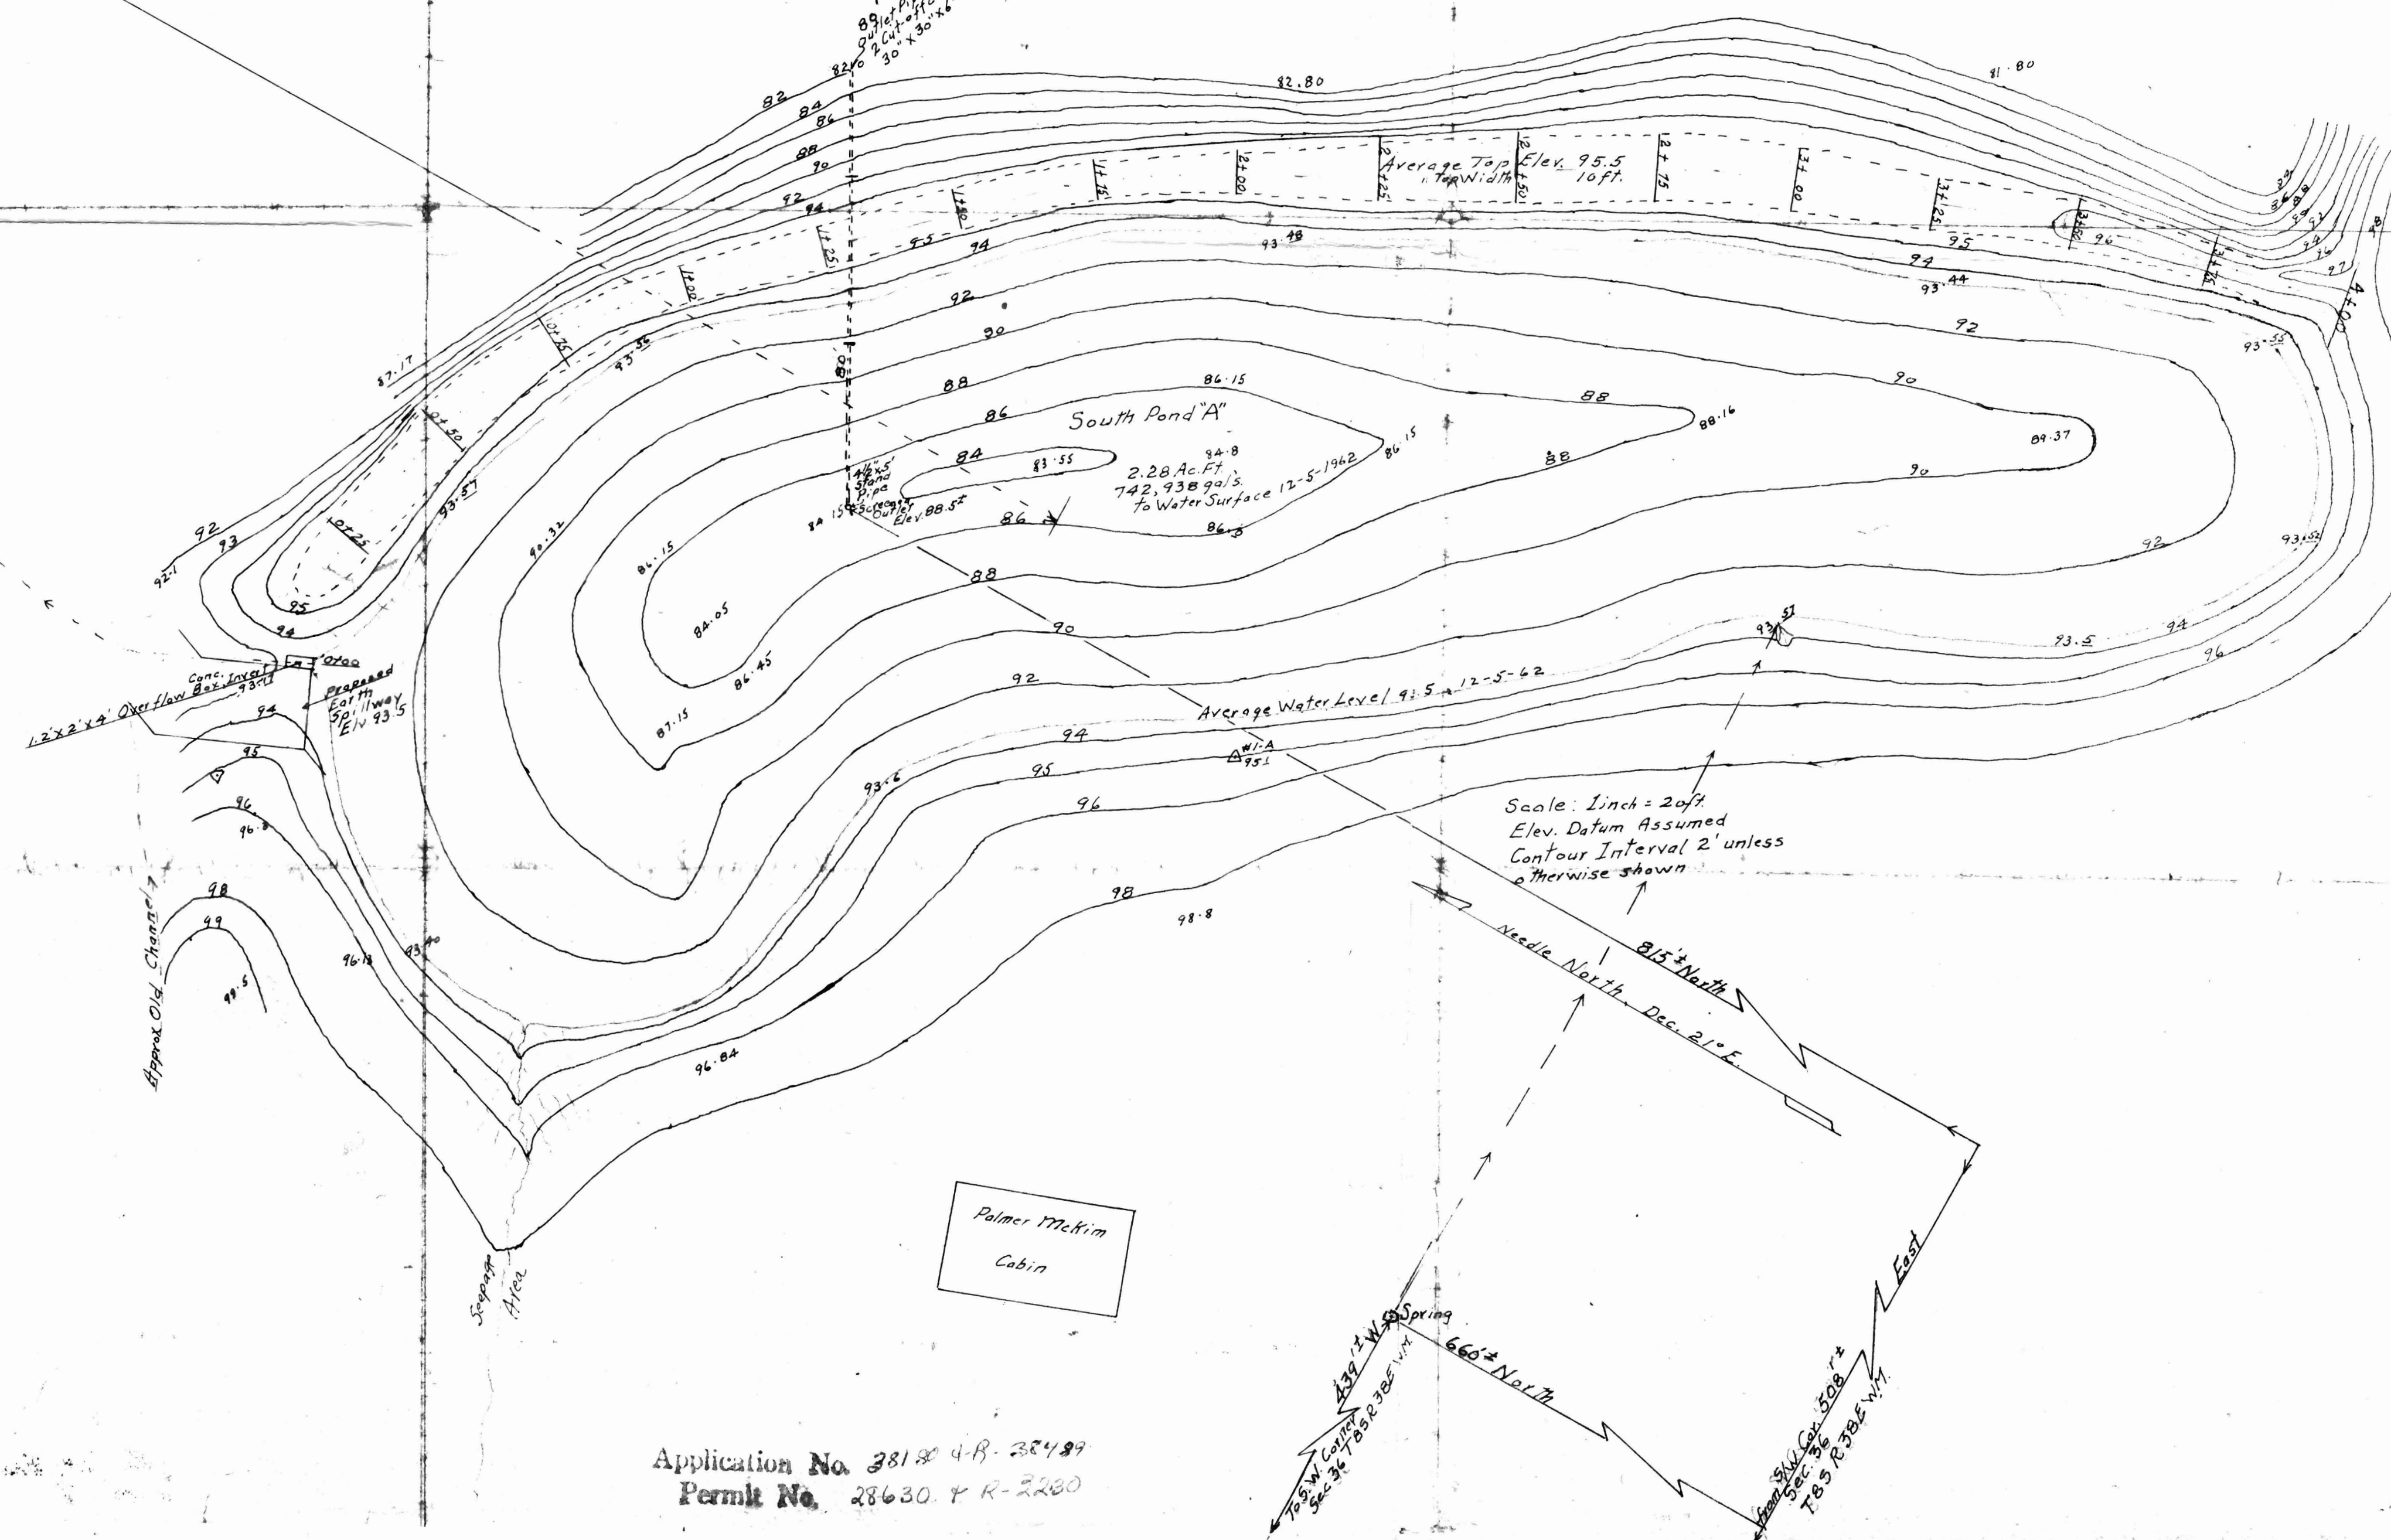

Application No. 28184-B-28489  
Permit No. 28630 + R-2280