Form A1-187
March 1961

UNITED STATES
DEPARTMENT OF THE INTERIOR
BUREAU OF LAND MANAGEMENT

SECTION

20

Oregon State Water Filings

TOWNSHIP 26S, RANGE 41E, W. M.

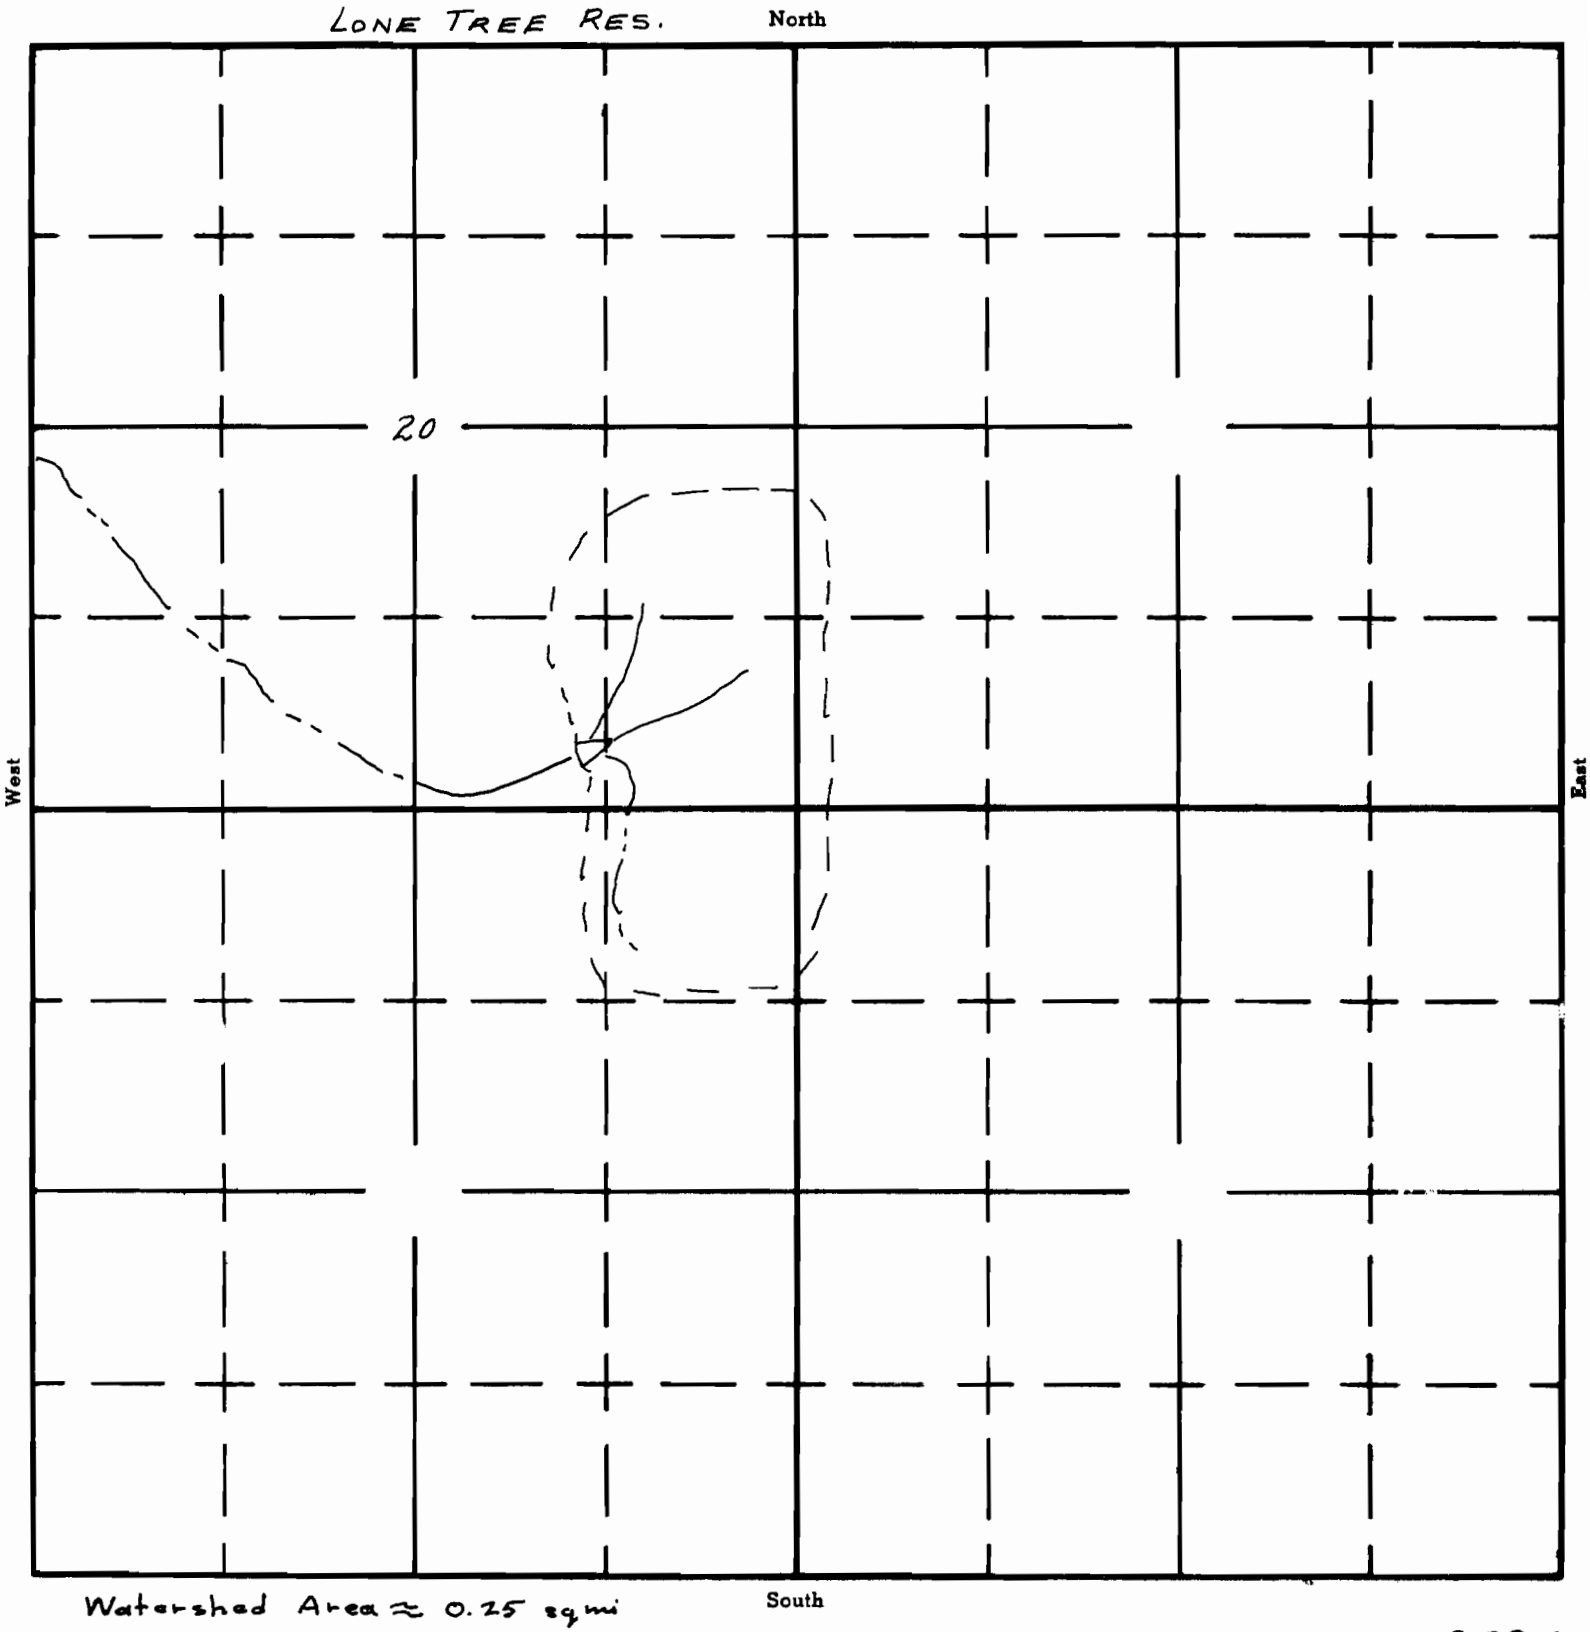

Watershed Area ≈ 0.25 sq mi

APPLICATION No. R-3952
PERMIT No. R-4420