


R-4509 15

33-6-22

T.33S.R.6W.W.M.

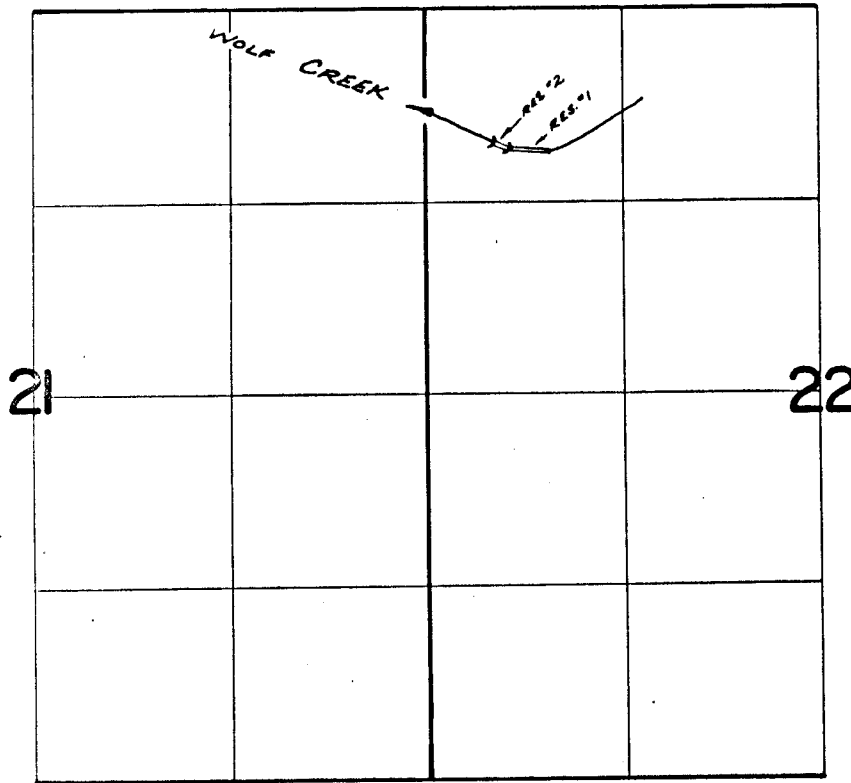

FINAL PROOF SURVEY
UNDER

Application No. ~~R-40336~~ Permit No. ~~R-4502~~ *R-4509*
IN NAME OF

JOSEPHINE COUNTY - A BODY POLITIC

INSPECTED
Surveyed *APR. 23, 1970*, by *R. MUCKEN*