


Permit: R 4513  
Volume: 8A  
Strm: PARKER CR>MENDENHA  
Trib: W FK ILLINOIS RIVE  
Priority: 1/20/65

# T.40S.,R.8&9W.,W.M.

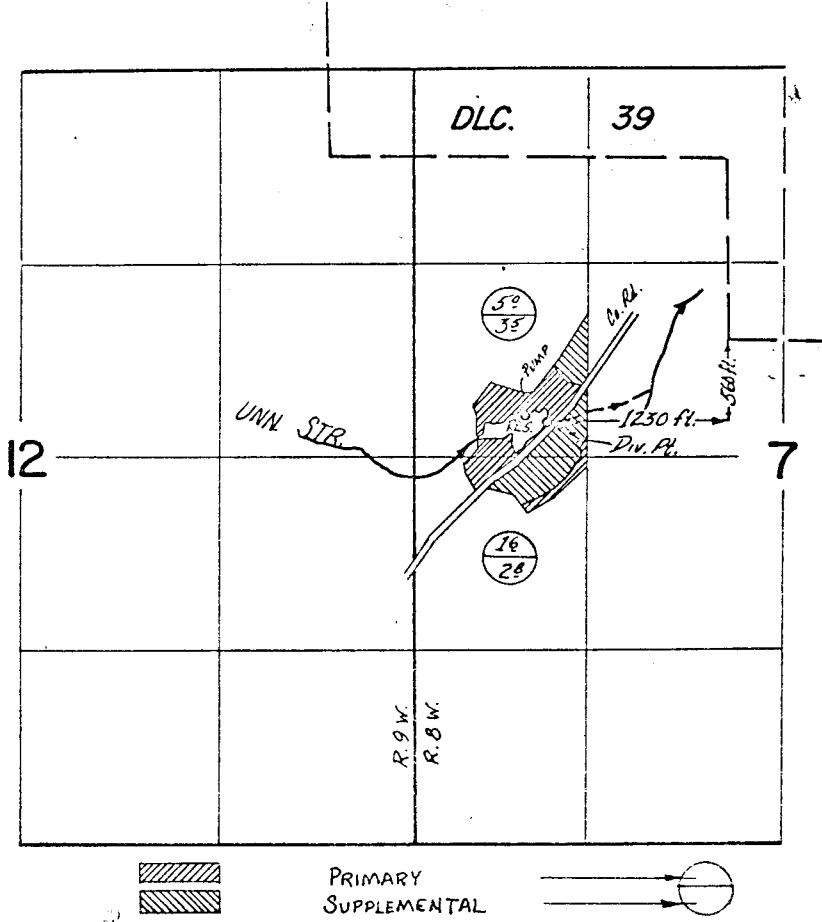

## FINAL PROOF SURVEY UNDER

R-40383                      R-4513  
Application No. 40384    Permit No. 30106  
IN NAME OF

WENDELL M. FALES

Surveyed 31 Oct. 1972, by L.E. GRUND