


T. 8 S. R. 1 W. W. M.

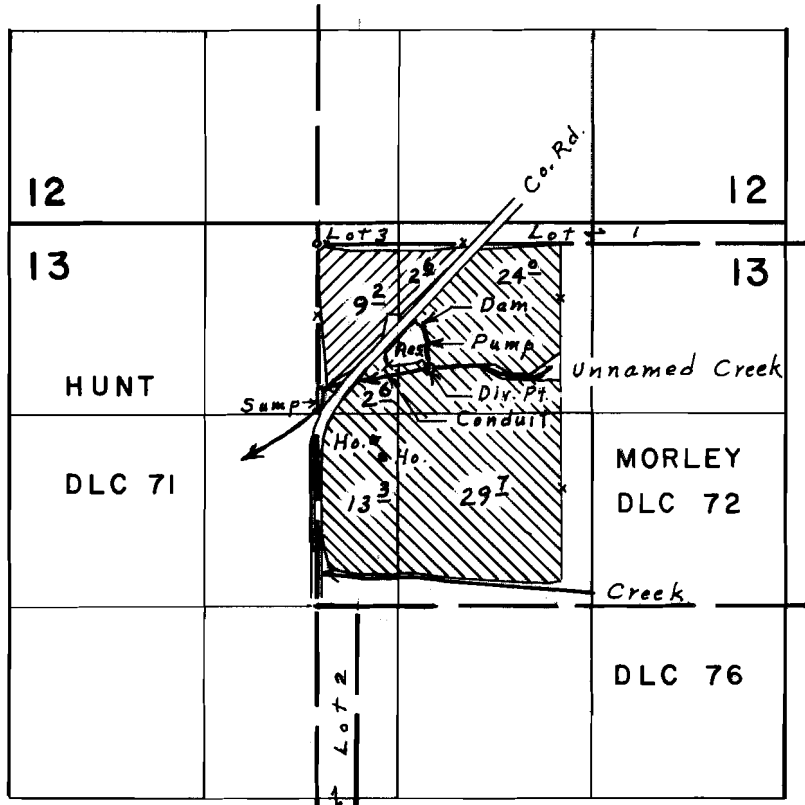

Div. Pts. located: Res. 680' S. & 750' E.; Unnamed Creek, 870' S. & 760' E.; Sump, 1080' S. & 20' E.; all from N.W. Cor. Morley D.L.C. 72

**FINAL PROOF SURVEY**  
UNDER

R-41279                      R-4644  
Application No. 41280    Permit No. 30782  
IN NAME OF  
**WALTER WINN**

Surveyed July 6, 1973, by L. E. Gould