


T.6S. R.8W. W.M.

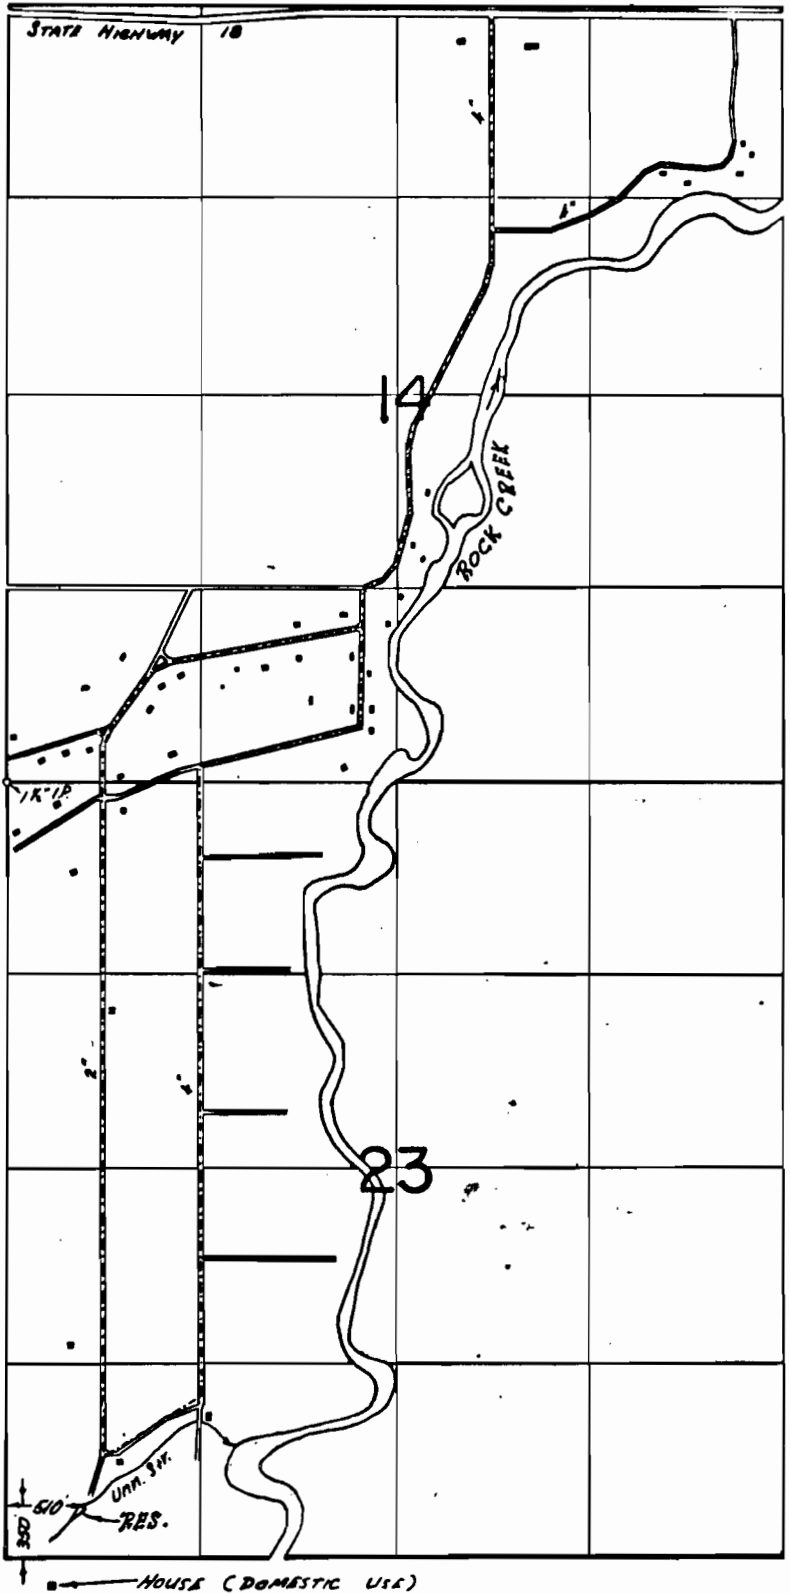

FINAL PROOF SURVEY

UNDER

Application No. R-42854 42855 Permit No. R-4872 32029

IN NAME OF

ROCK CREEK HIDEOUT WATER CO.

Surveyed April 26 1974 by T. J. PAUL