


T. 41 S., R. 8 W., W. M.

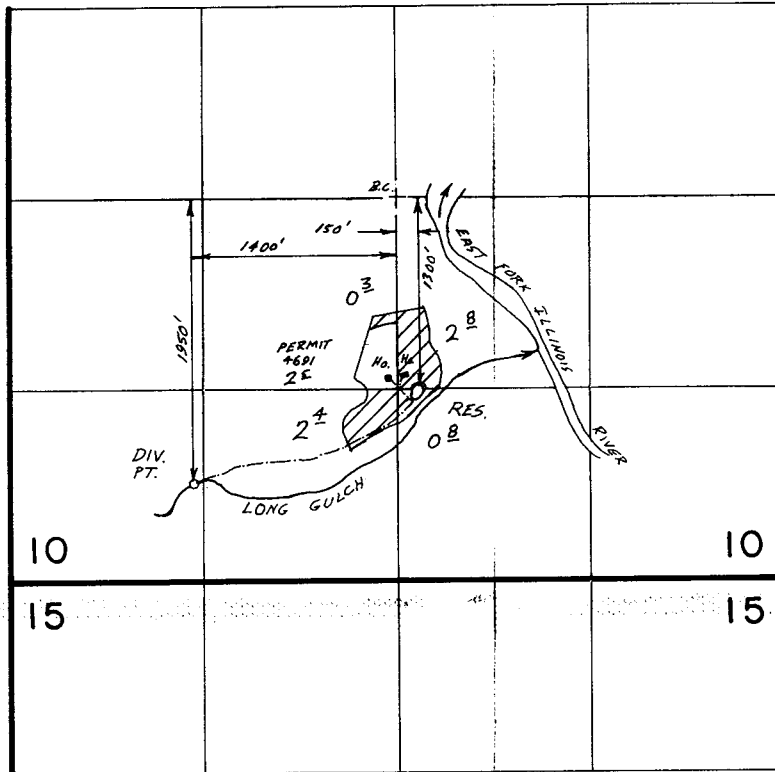

Scale: 1" = 1320'

JUL 14 1988

WM. DIST. 14  
GRANTS PASS, ORE.

**FINAL PROOF SURVEY**  
UNDER

R-42949

R-4967

Application No. 42950 Permit No. 32370  
IN NAME OF

LESLIE W. ORMSBY

Surveyed APR. 18. 19.86, by B. S. JAMES