


Permit: R 5104
 Volume: 5
 Strm: UNN STR
 Trib: QUARTZ CR
 Priority: 10/20/67

RECEIVED
 DEC 13 1974
 WM. DIST. 14
 GRANTS PASS, ORE

T.35S.R.6W.W.M.

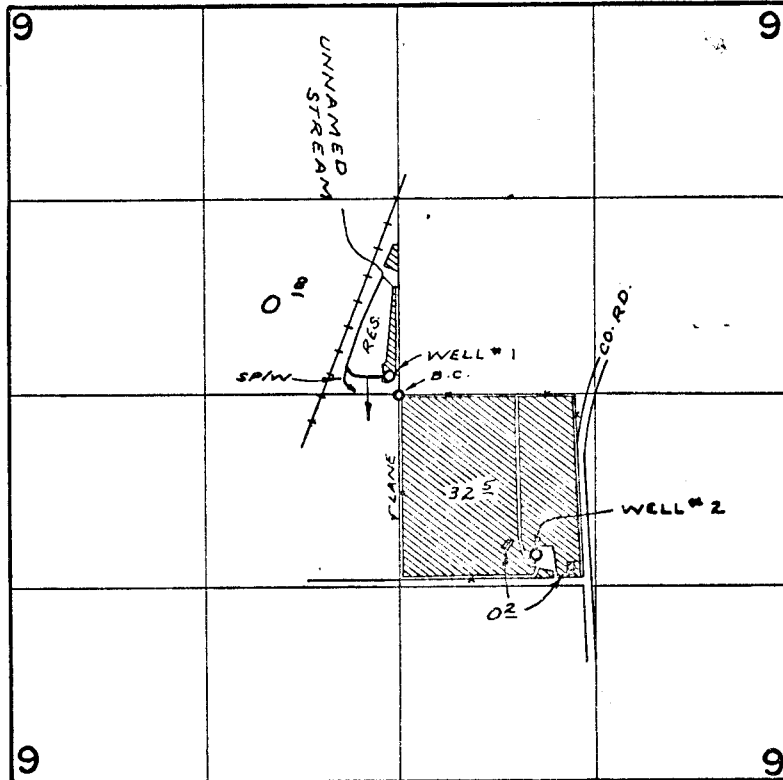

DIV. PTS LOC: WELL #1 - 120' N & 70' W; WELL #2 - 1100' S & 930' E.
 STREAM - 120' N. & 220' W, ALL FROM GEN. SEC. 9
 WELL #1 RES - [diagonal hatching] WELL #2 - [diagonal hatching]

FINAL PROOF SURVEY
 UNDER

R-44177 R-5109
 44178 33008
 R-45707 R-5413
 45708 34095

Application No. G-4769 Permit No. G-4488
 IN NAME OF

BUREAU OF LAND MANAGEMENT

Surveyed APR. 17, 1972, by R. MUCKEN