


R 5 266

T. 24 S. R. 27 E. W.M.

T. 25 S. R. 28 E. W.M.

T. 25 S. R. 29 E. W.M.

T. 25 S. R. 27 E. W.M.

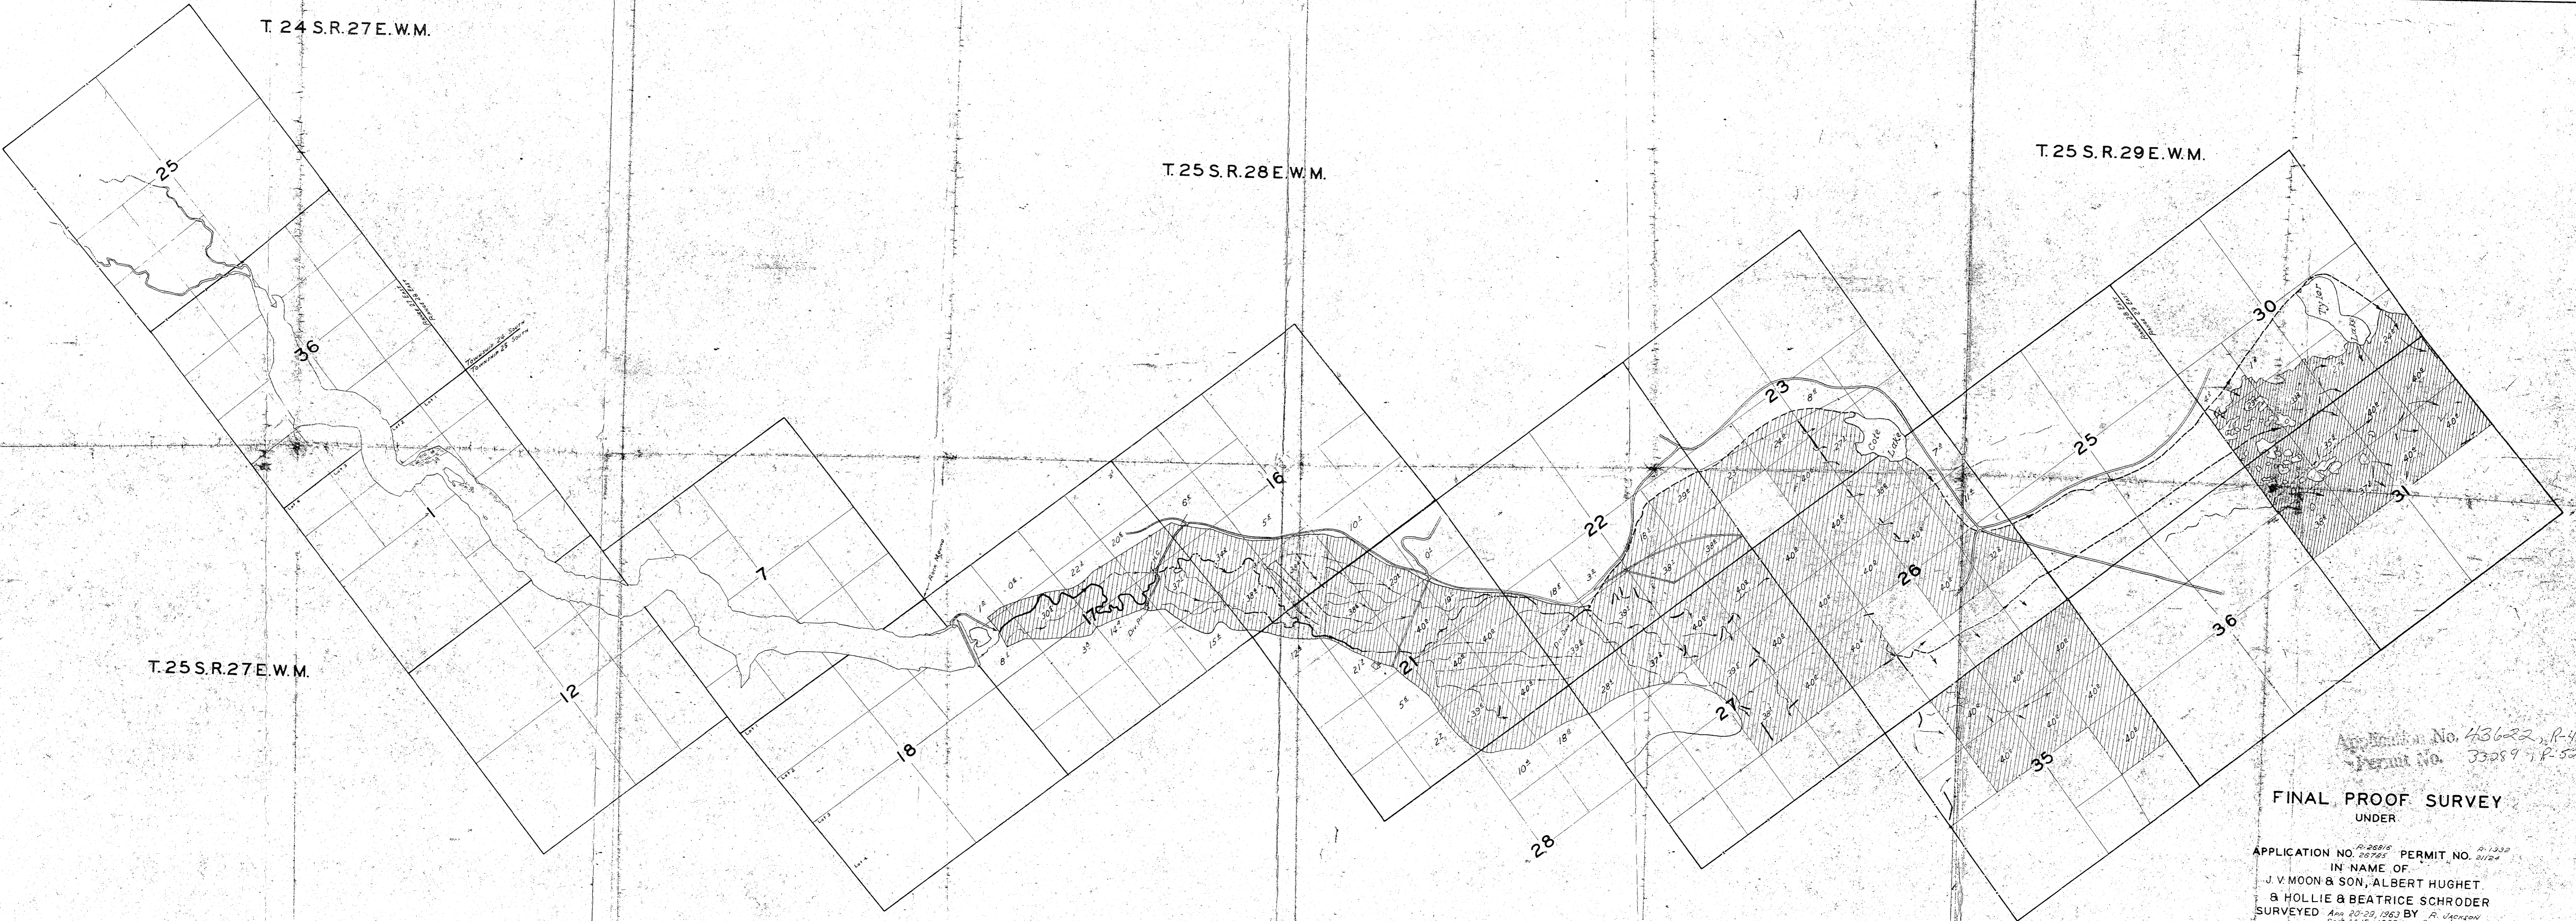

Application No. 43622, R-43621  
Permit No. 33089, R-5266

**FINAL PROOF SURVEY**  
UNDER

APPLICATION NO. <sup>R-26818</sup> 20725 PERMIT NO. <sup>R-1332</sup> 21124  
IN NAME OF  
J. V. MOON & SON, ALBERT HUGHET  
& HOLLIE & BEATRICE SCHRODER  
SURVEYED <sup>Apr 20-29, 1963</sup> BY <sup>R. Jackson</sup>  
