Round Prairie Lbr. Co
Dillard, Oregon

R-45412
45286

RECEIVED
OCT 1 1969
STATE ENGINEER
SALEM, OREGON

PLAN | SURVEYED | BY | DATE
PLOTTED
NOTE BOOK | ALIGNMENT CHECKED
NO | PLAN REVISED

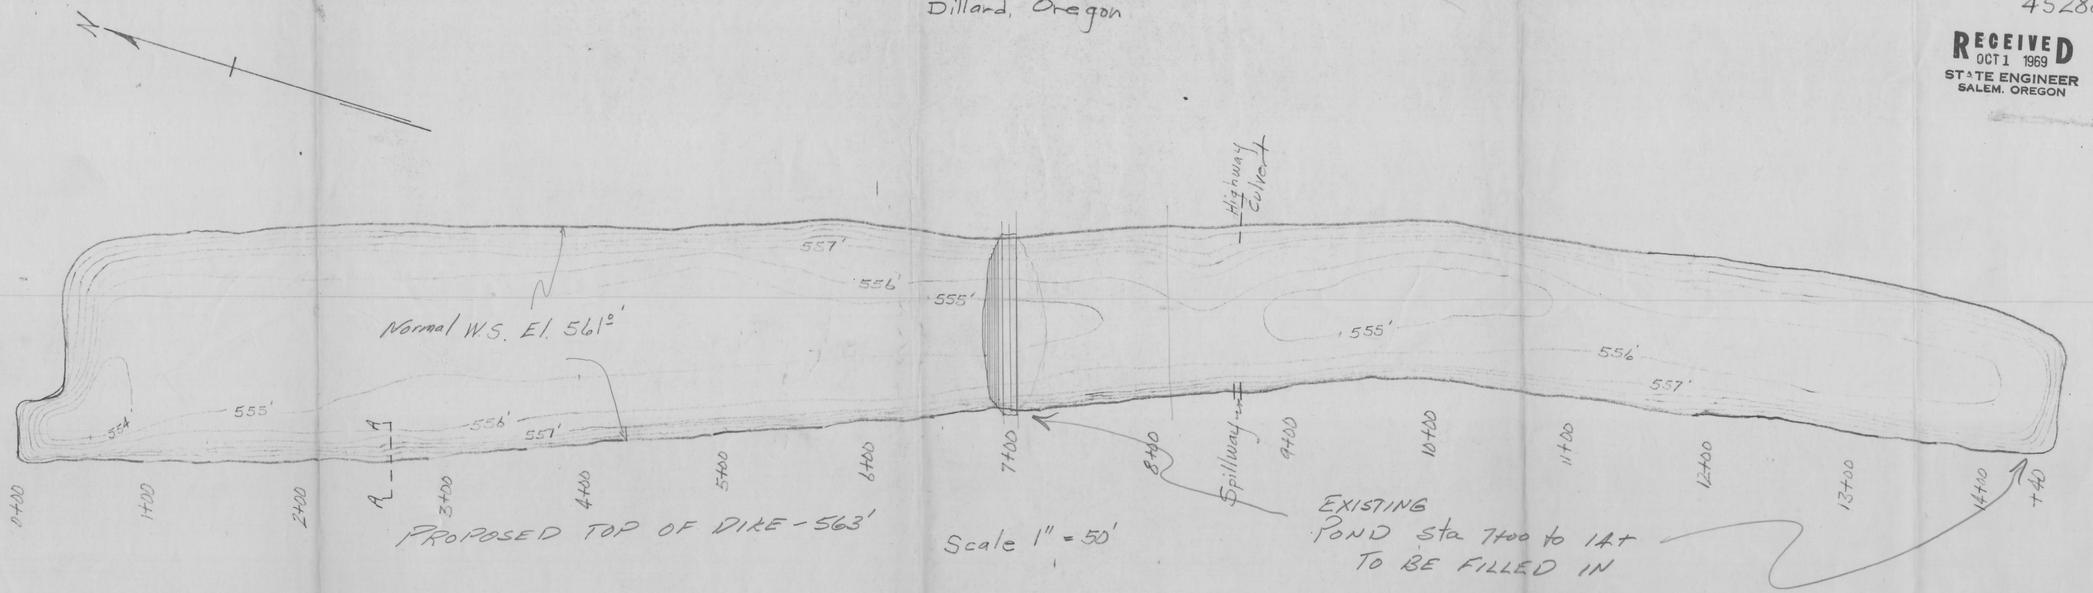

PROFILE | SURVEYED | BY | DATE
PLOTTED
NOTE BOOK | GRADES CHECKED
NO | STRUCTURE NOTATNS CHKD.

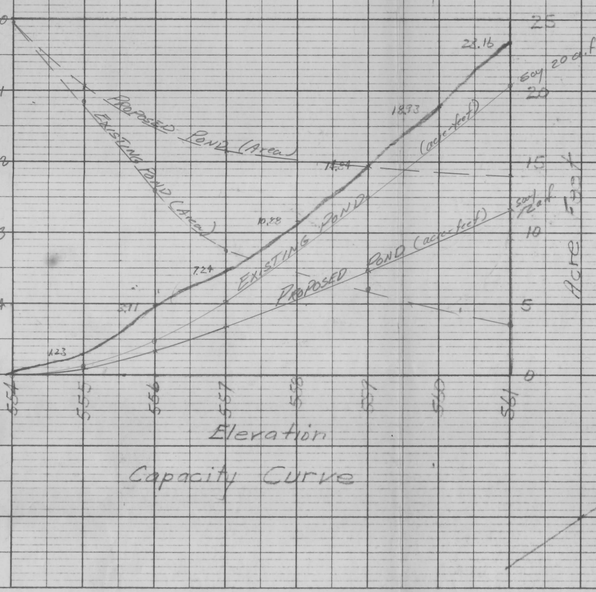

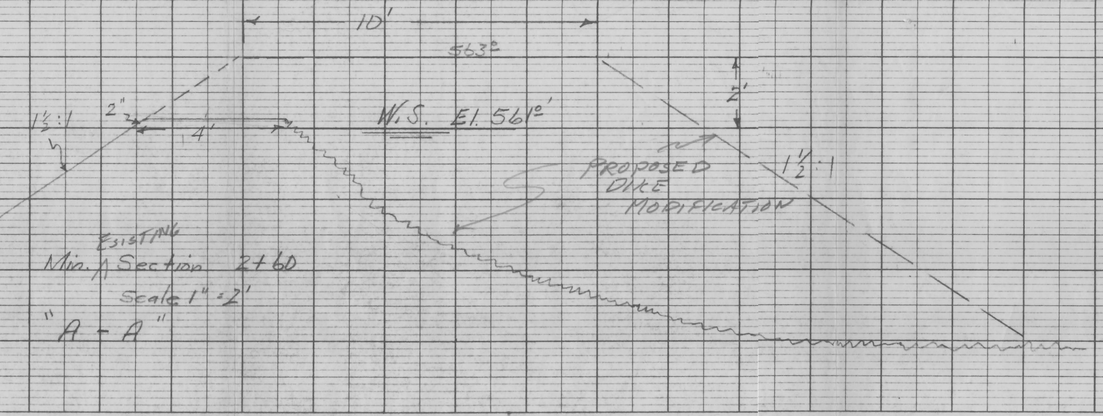

Log

Station	Dike width	Height above W.S.
0+00	13'	18"
1+00	15'	24"
2+00	11'	19"
2+60	4'	2"
3+00	4.5'	3"
4+00	8.5'	7"
5+00	8'	7"
6+00	8'	7"
7+00	11'	7"
7+50	11'	9"
8+00	12'	12"
9+00	10'	12"
10+00	8'	26"
11+00	8'	30"
12+00	13'	36"
13+00	13'	36"
14+40	14'	36"

RECEIVED
SEP 19 1969
STATE ENGINEER
SALEM, OREGON

PLATE 1 - PLAN-PROFILE O.P.R.&R.E. STANDARD
1000 RAG PAPER, MADE AND PRINTED IN U. S. A.
EUGENE DIETZGEN CO.

Application No. R-45412 & 45286 Sept 15, 1969
Permit No. R 5460