


T. 36S.R.1W.W.M.

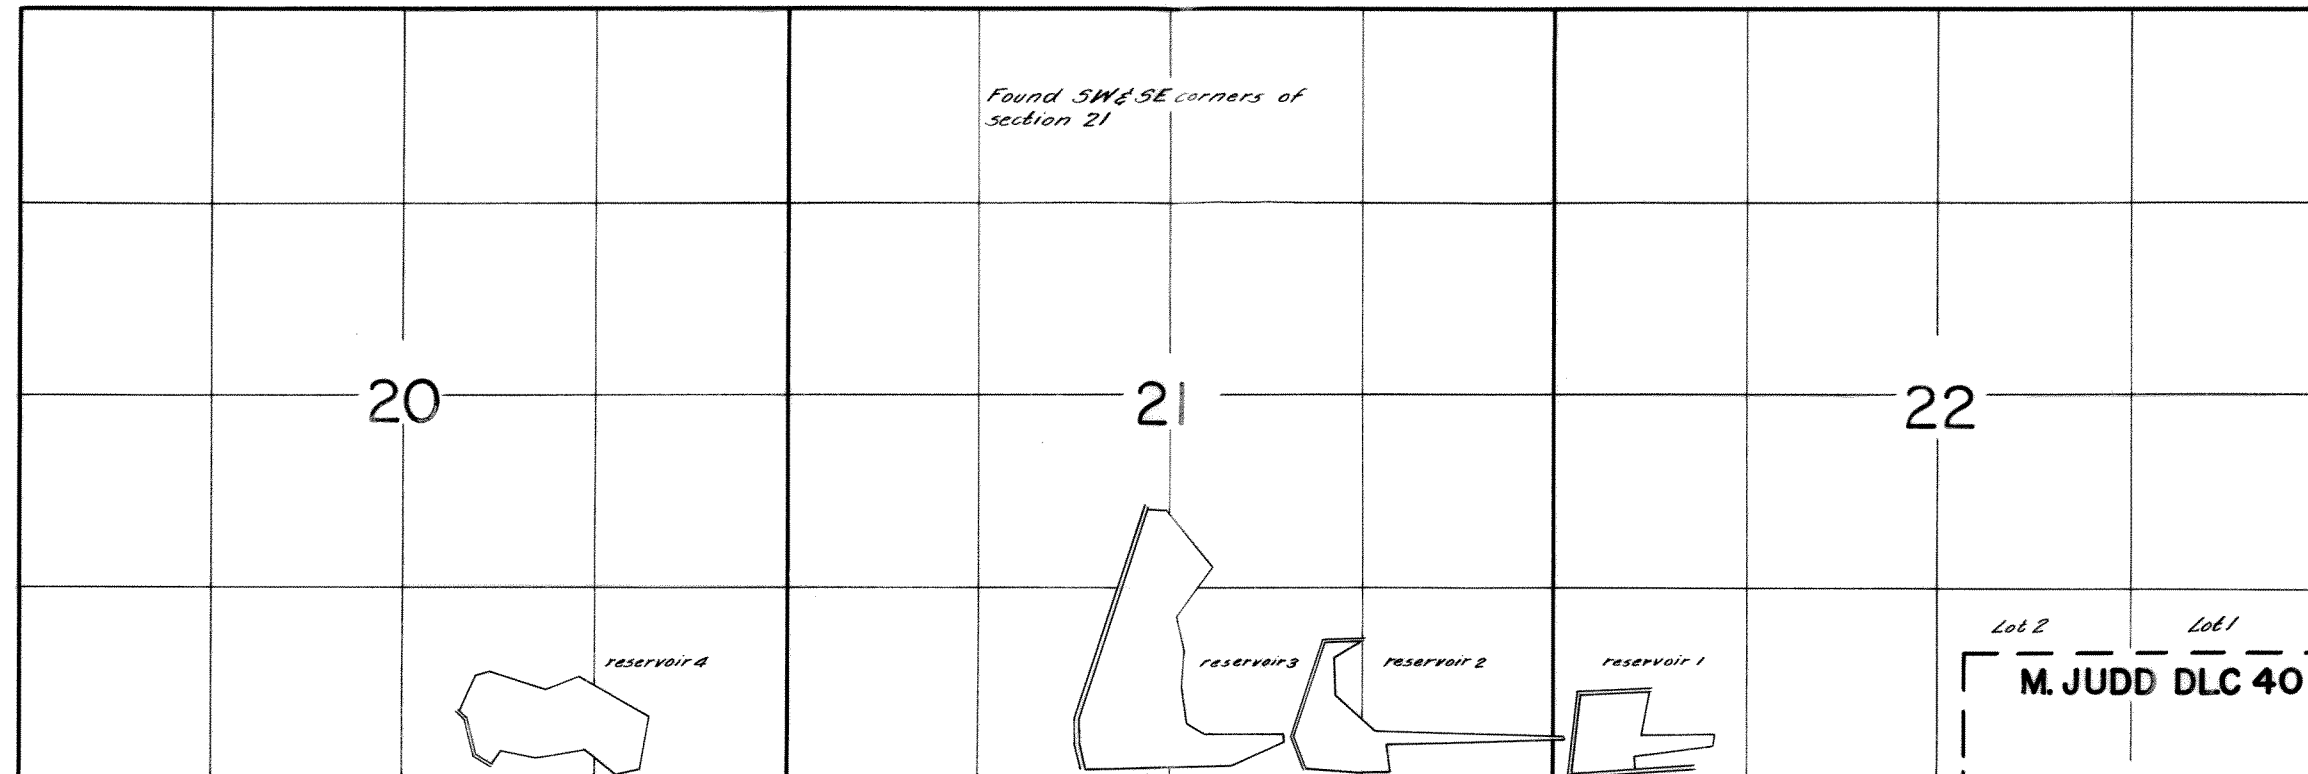

FINAL PROOF SURVEY

Appl. No. 34606 Permit No. 27198
R-34605 R-2588

MELVIN & ROSALIND HOOVER

Surveyed May 18, 1963 by C. Baker