


WATER RIGHT MAP

FOR: WALT ERDMAN  
RT. 1, BOX 59  
HILLSBORO, ORE.

TOWNSHIP 1 SOUTH, RANGE 3 WEST, W.M.

SECTION 12

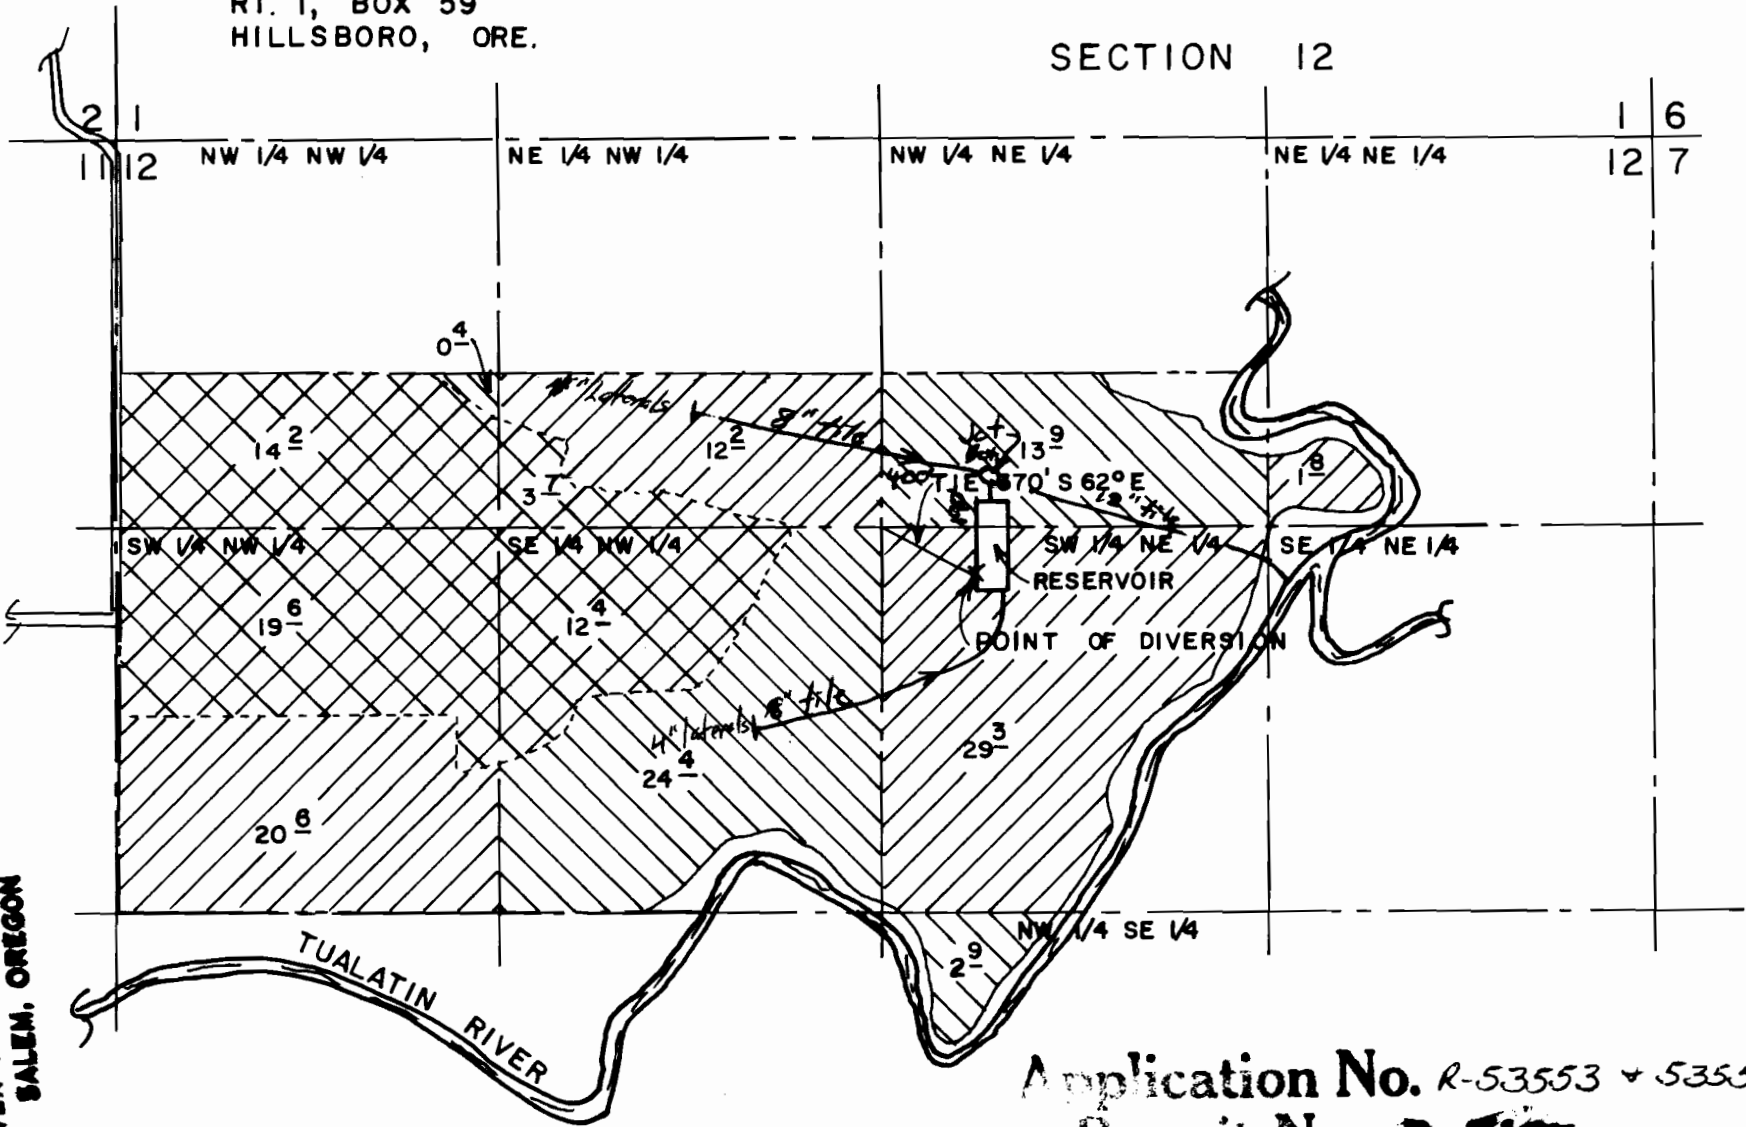

RECEIVED

AUG 18 1975

WATER RESOURCES DEPT  
SALEM, OREGON



AREA #1 = 50 <sup>5</sup>/<sub>8</sub> ACRES *not included in this project*



AREA #2 = ~~104~~ ACRES 105.5

Application No. R-53553 + 53554

Permit No. R 6195 38413