
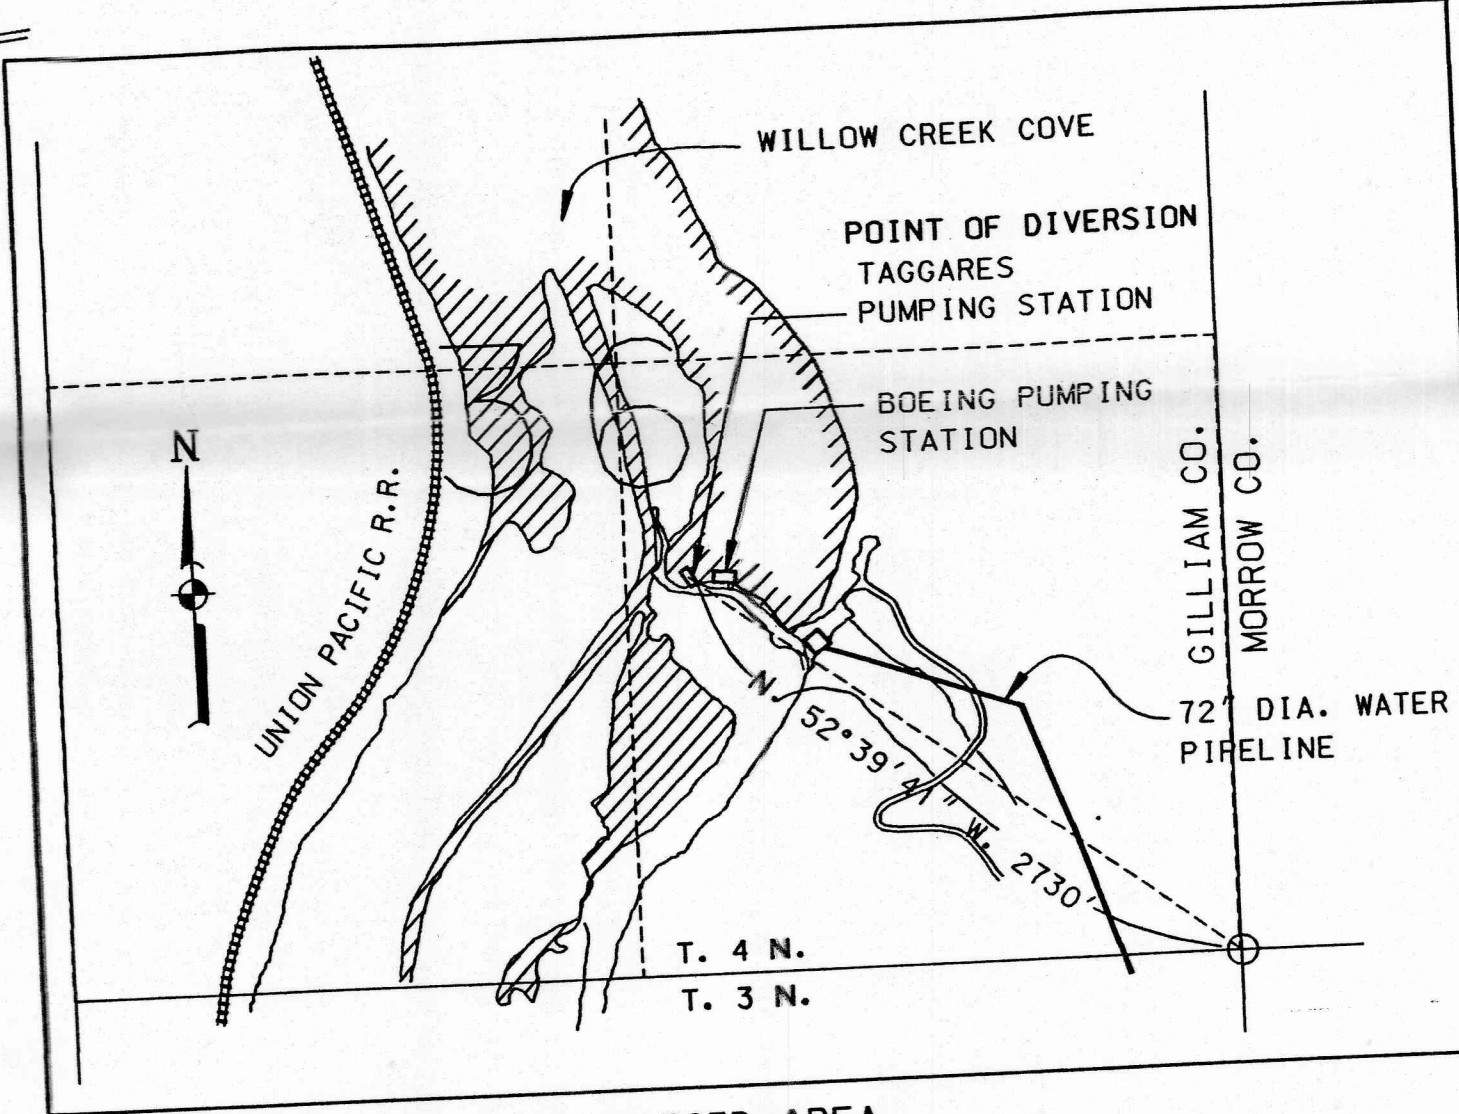


LAKE UMATILLA

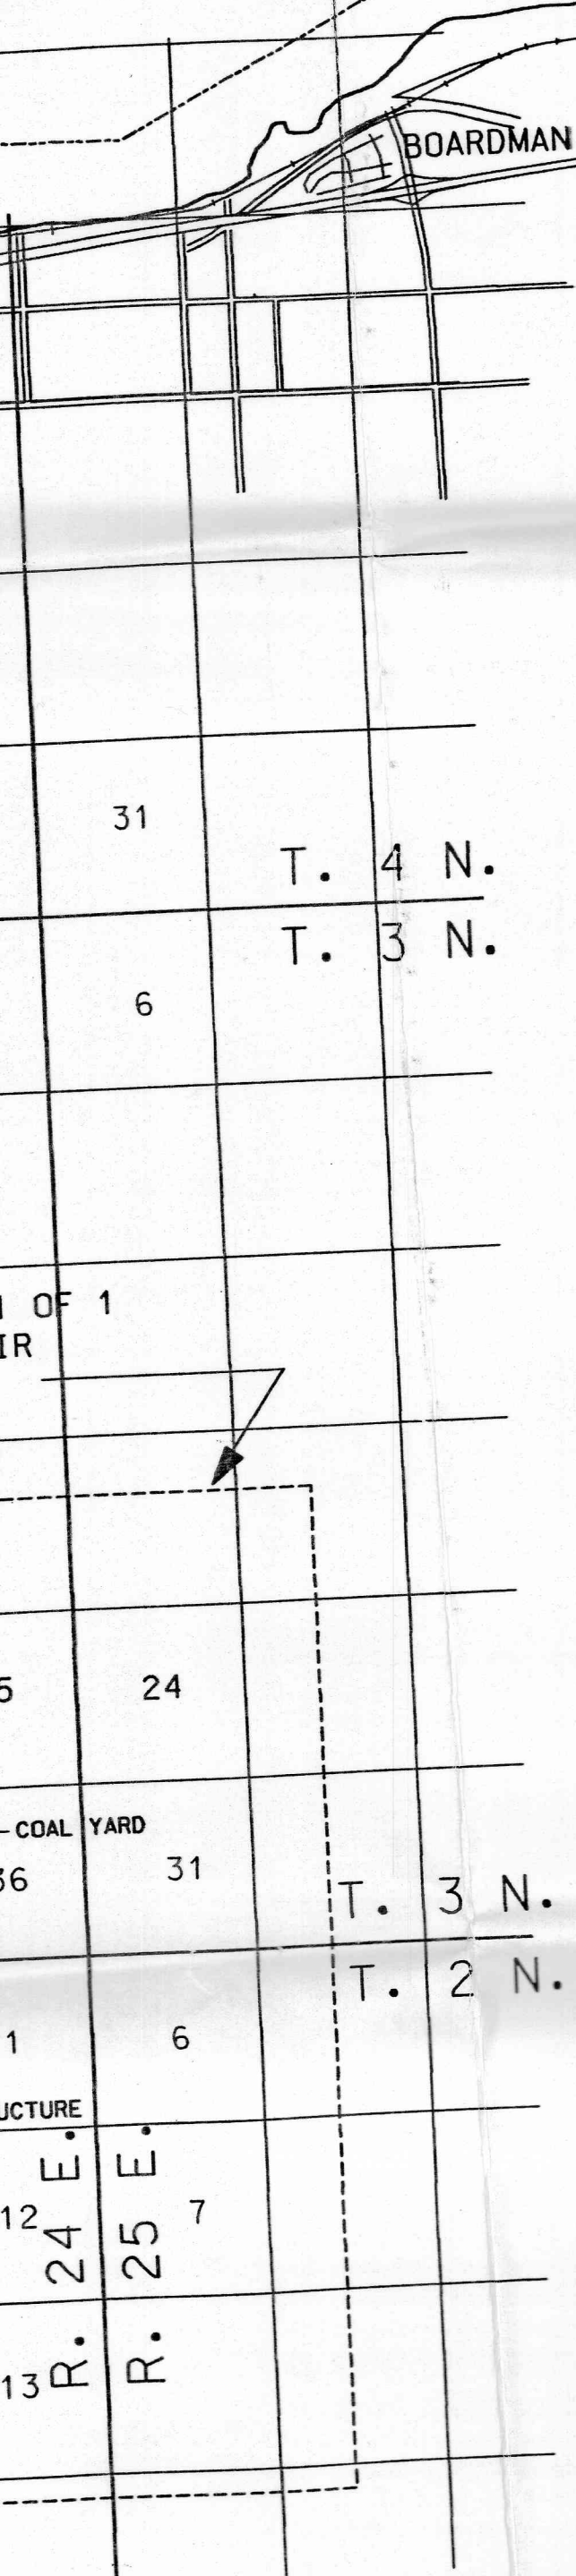

ENLARGED AREA
SCALE: 1 INCH = 1000 FT

LEGEND
 - AREA OF BENEFICIAL USE


REFERENCE DRAWING

BOARDMAN COAL PLANT
D10820 SHEET 1 OF 1

CARTY RESERVOIR
FINAL PROOF MAP
PERMIT NUMBER R6276

RECEIVED

MAY 21 1996
WATER RESOURCES DEPT.
SALEM, OREGON

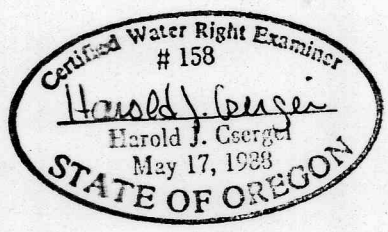

0	5/5	ISSUED FOR WATER RIGHTS	JAV		HSC
REV	DATE	PERMIT NUMBER 39188	BY	CHK	SUPV
		DESCRIPTION			ENG
REVISIONS					
PORTLAND GENERAL ELECTRIC PORTLAND, OREGON					
BOARDMAN COAL PLANT CARTY RESERVOIR MAKEUP AND PROCESS WATER SYSTEM WATER RIGHTS FINAL PROOF MA PERMIT NUMBER 39188					
APPROVALS			SCALE 1" = 1 M		
DESIGNER	JAV	DRAWN BY	JAV		
DESIGN ENGINEER	HSC	CHECKED BY			
DESIGN SUPERVISOR		DATE	MAY 5, 1996		
ENGINEER MANAGER		DRAWING NUMBER	D10728		
JOB NUMBER					

USE OF THIS MAP IS TO IDENTIFY
LOCATION OF THE WATER RIGHT. IT
INTENDED TO PROVIDE INFORMATION
TO THE LOCATION OF PROPERTY
BOUNDARY LINES.