

WATER RIGHT MAP

RECEIVED

FOR: DONALD LEIGHTMAN  
5335 N.W. 253 AVE.  
HILLSBORO, OREGON

RECEIVED

DEC 9 1974

STATE ENGINEER  
SALEM, OREGON


DEC 27 1974  
STATE ENGINEER  
SALEM, OREGON

TOWNSHIP 1 NORTH, RANGE 2 WEST, W. M.

SECTION 21 RECEIVED

NOV 12 1975

WATER RESOURCES DEPT.  
SALEM, OREGON

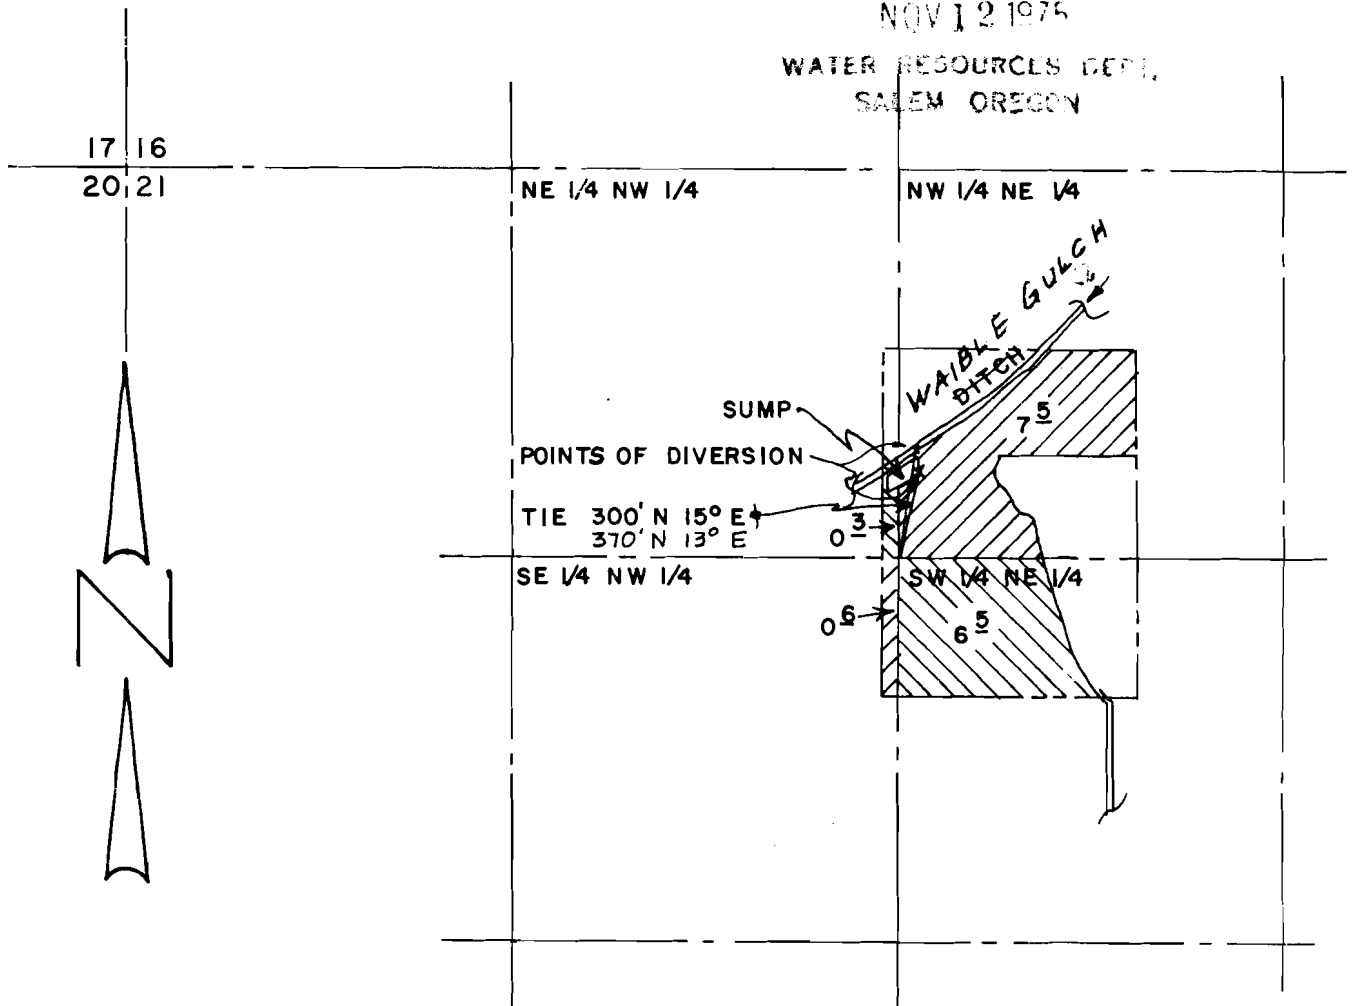

Application No. 52463  
Permit No. 39451

✕ R-53753  
✕ R 6318