


Application No. R-54263 + 54264  
Permit No. R 6478 & 40592

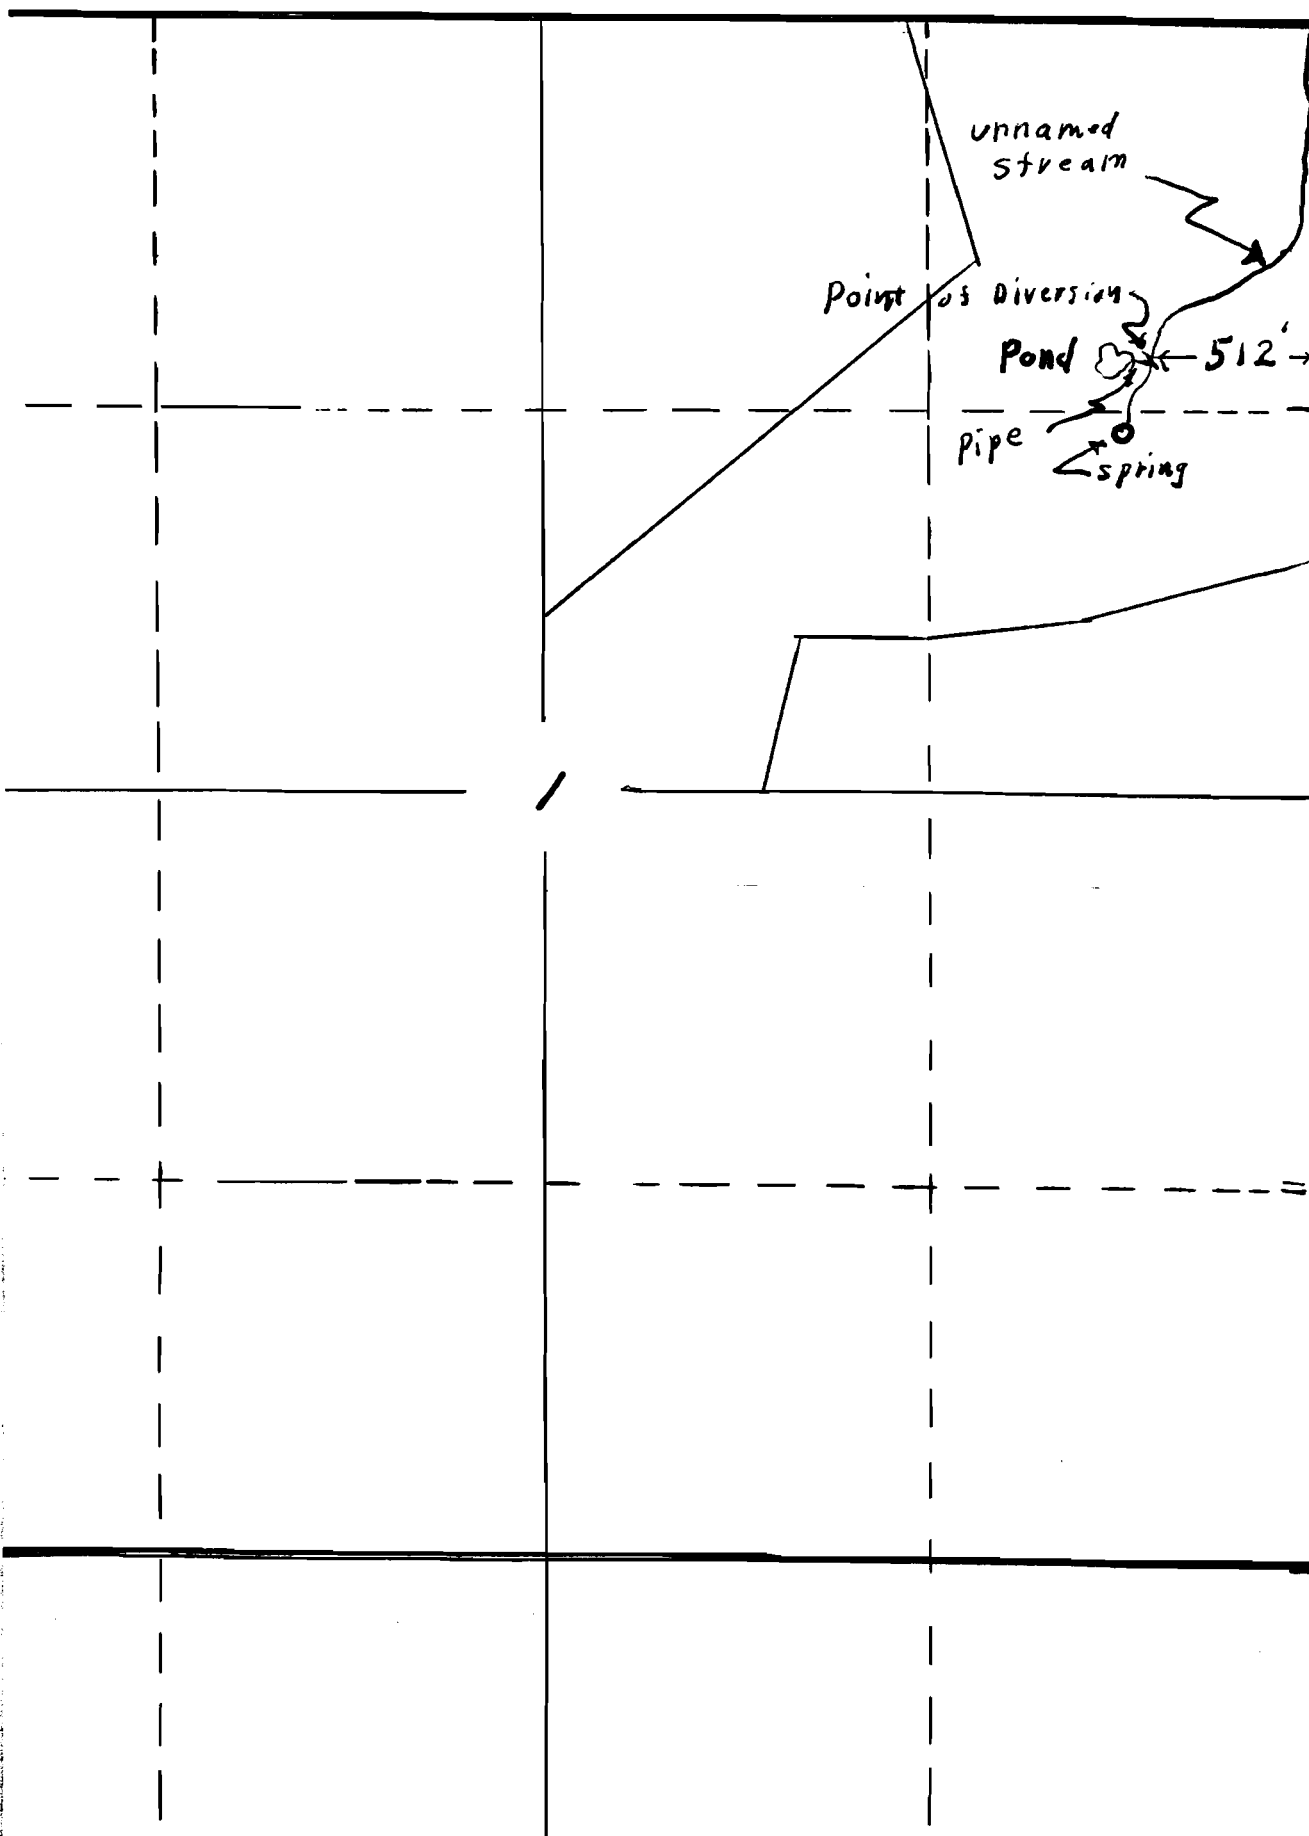

Sec I

6411

TP 6S

RAW

scale =  
8" = 1 mile

**RECEIVED**  
MAY 13 1976  
WATER RESOURCES DEPT  

E