


T.I.S.R.I.W.W.M.

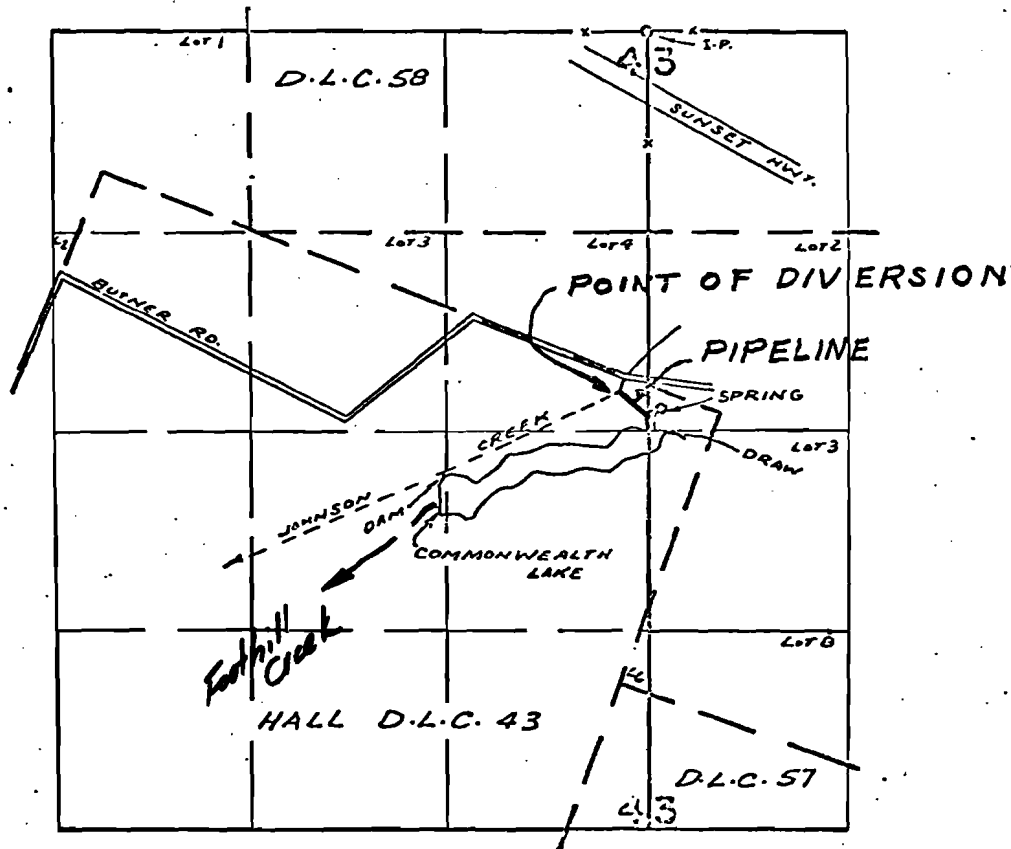

DAM LOC: 2940'S. & 1360'W. FROM N.E. COR. SEC. 4
DIV. PT. 245'N. & 170'W. OF E 1/4 COR SEC. 4

Application No.
Permit No.

R-54240, 54241
R-6488, 40685

RECEIVED

MAY 10 1976

WATER RESOURCES DEPT
SALEM, OREGON

RECEIVED

WATER RESOURCES DEPT
SALEM, OREGON