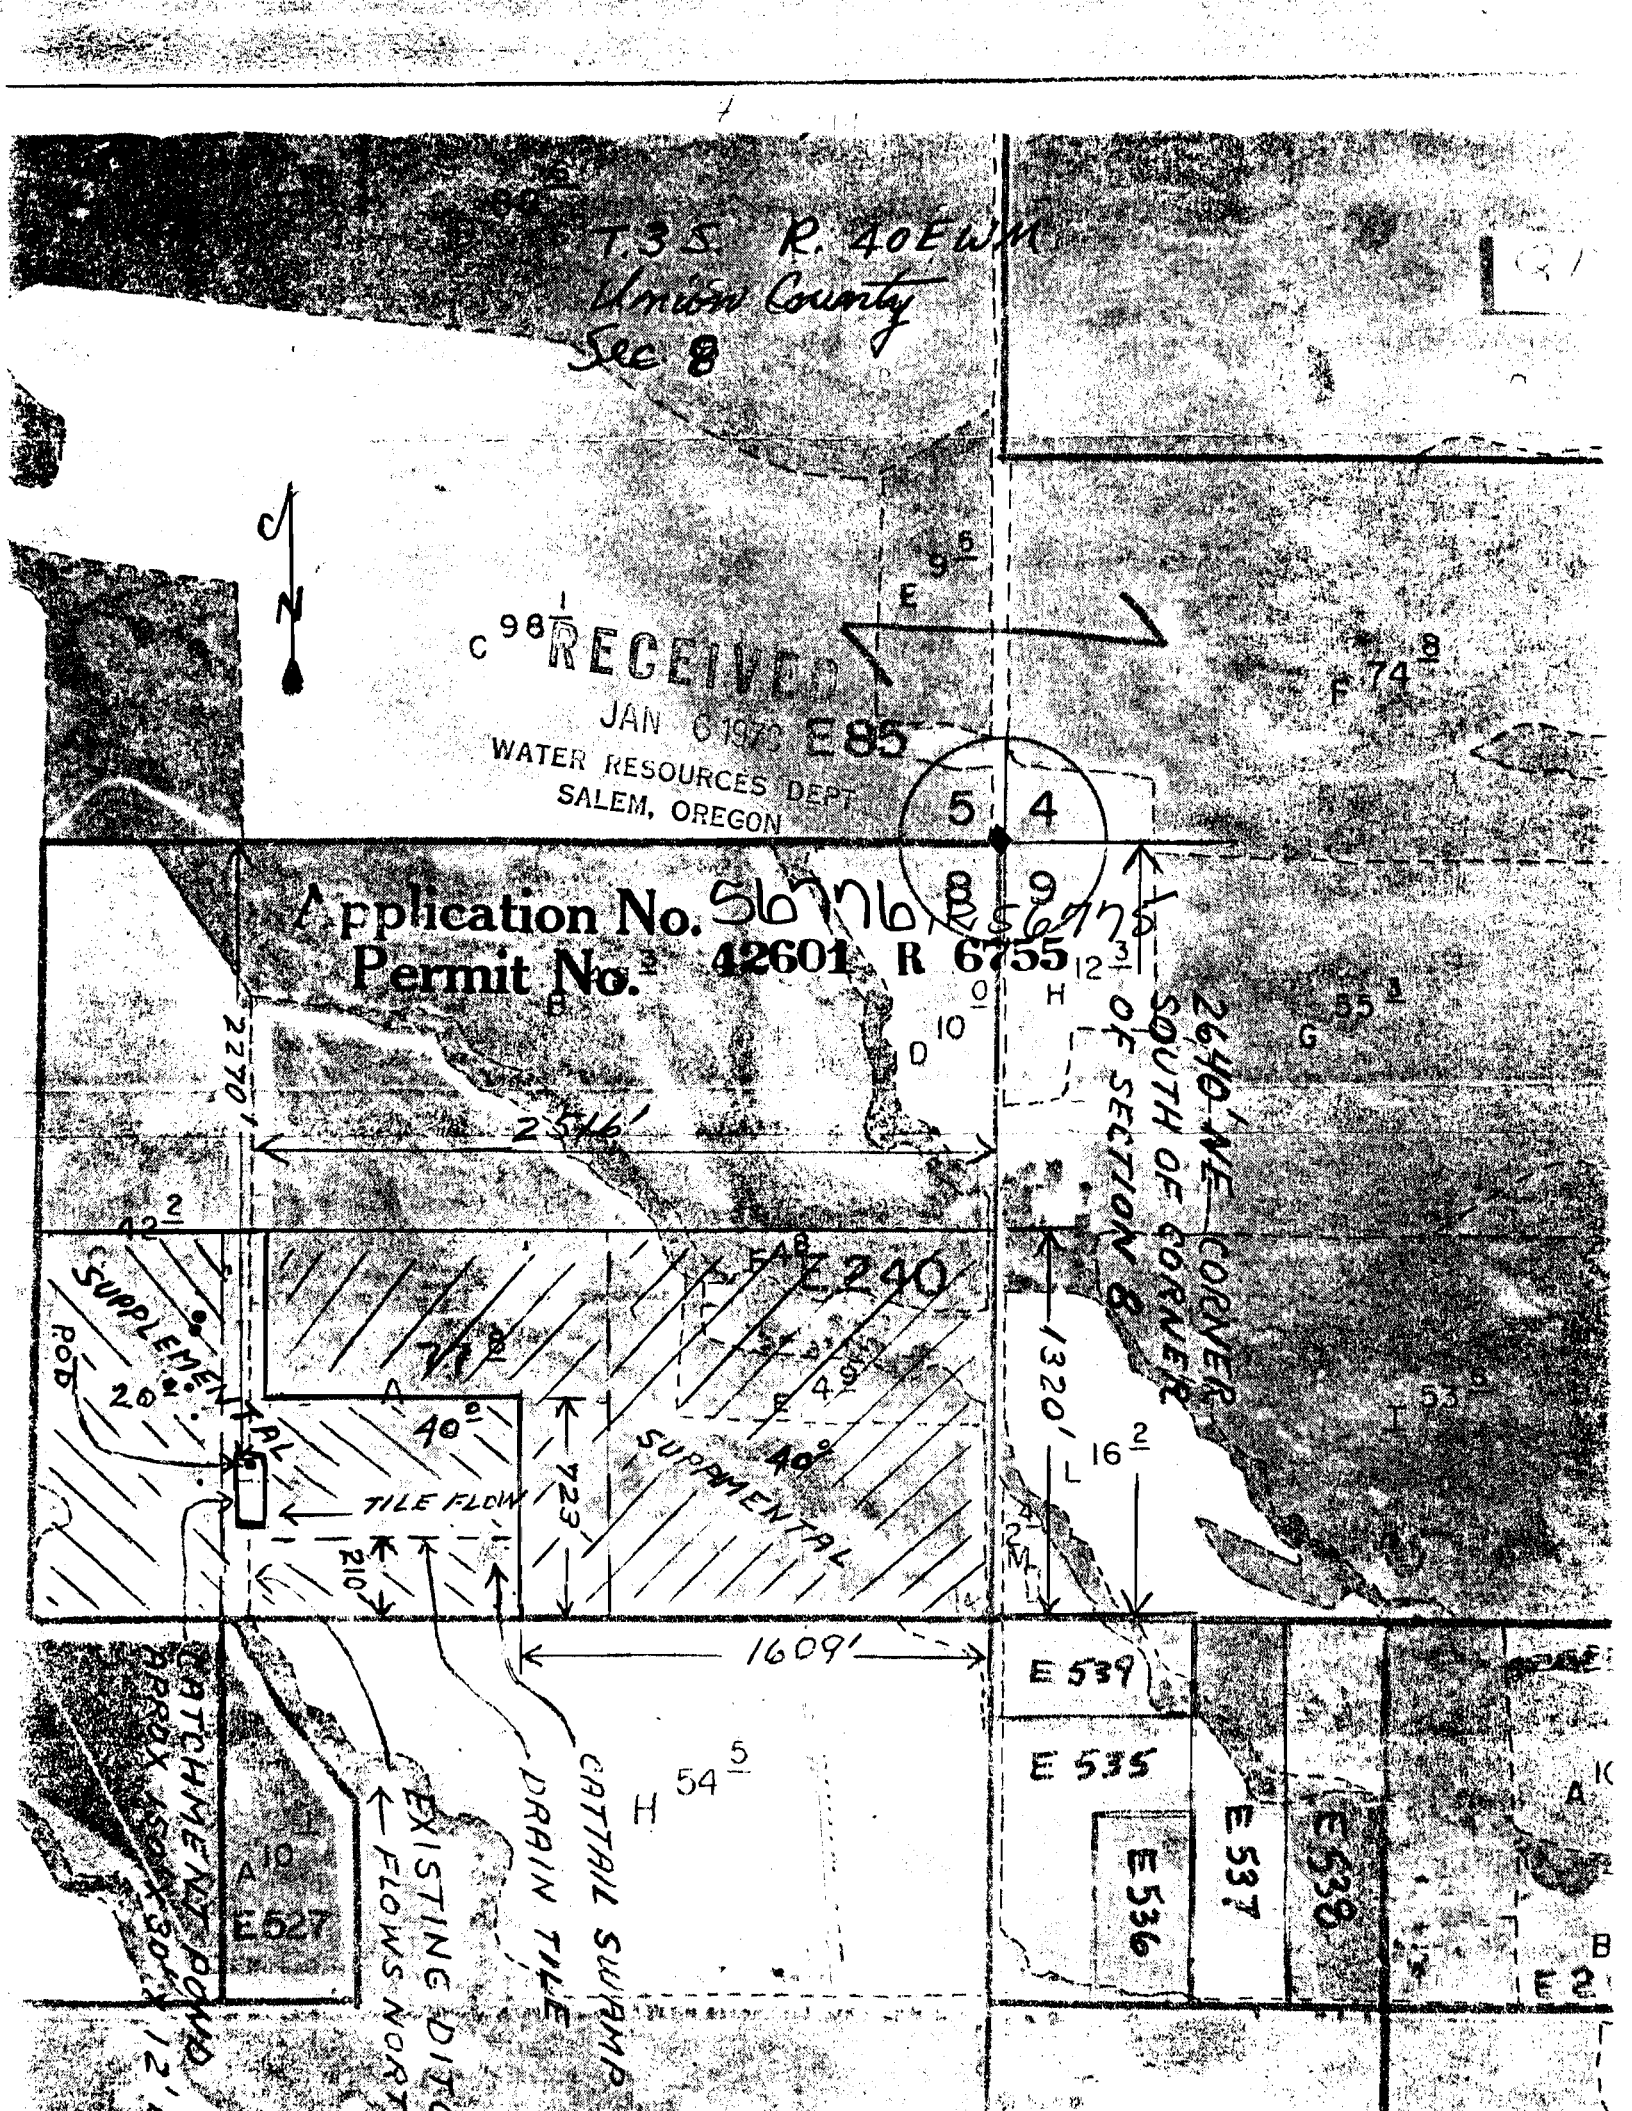
T.3 S. R. 40 E W.M.
Union County
Sec. 8
RECEIVED
JAN 6 1970
WATER RESOURCES DEPT
SALEM, OREGON
Application No. 56776 R 56775
Permit No. 42601 R 6755
2270'
2516'
2640' NE CORNER
SOUTH OF CORNER
OF SECTION 8
1320'
E 240
SUPPLEMENTAL
TILE FLOW
723'
1609'
E 539
E 535
E 536
E 537
E 538
E 527
CATTAIL SWAMP
DRAIN TILE
EXISTING DITCH
FLOWS NORTH
CATCHMENT POND
APPROX 150' X 30' X 12'