


SECTION

TOWNSHIP 25, RANGE 46E, W. M.

North

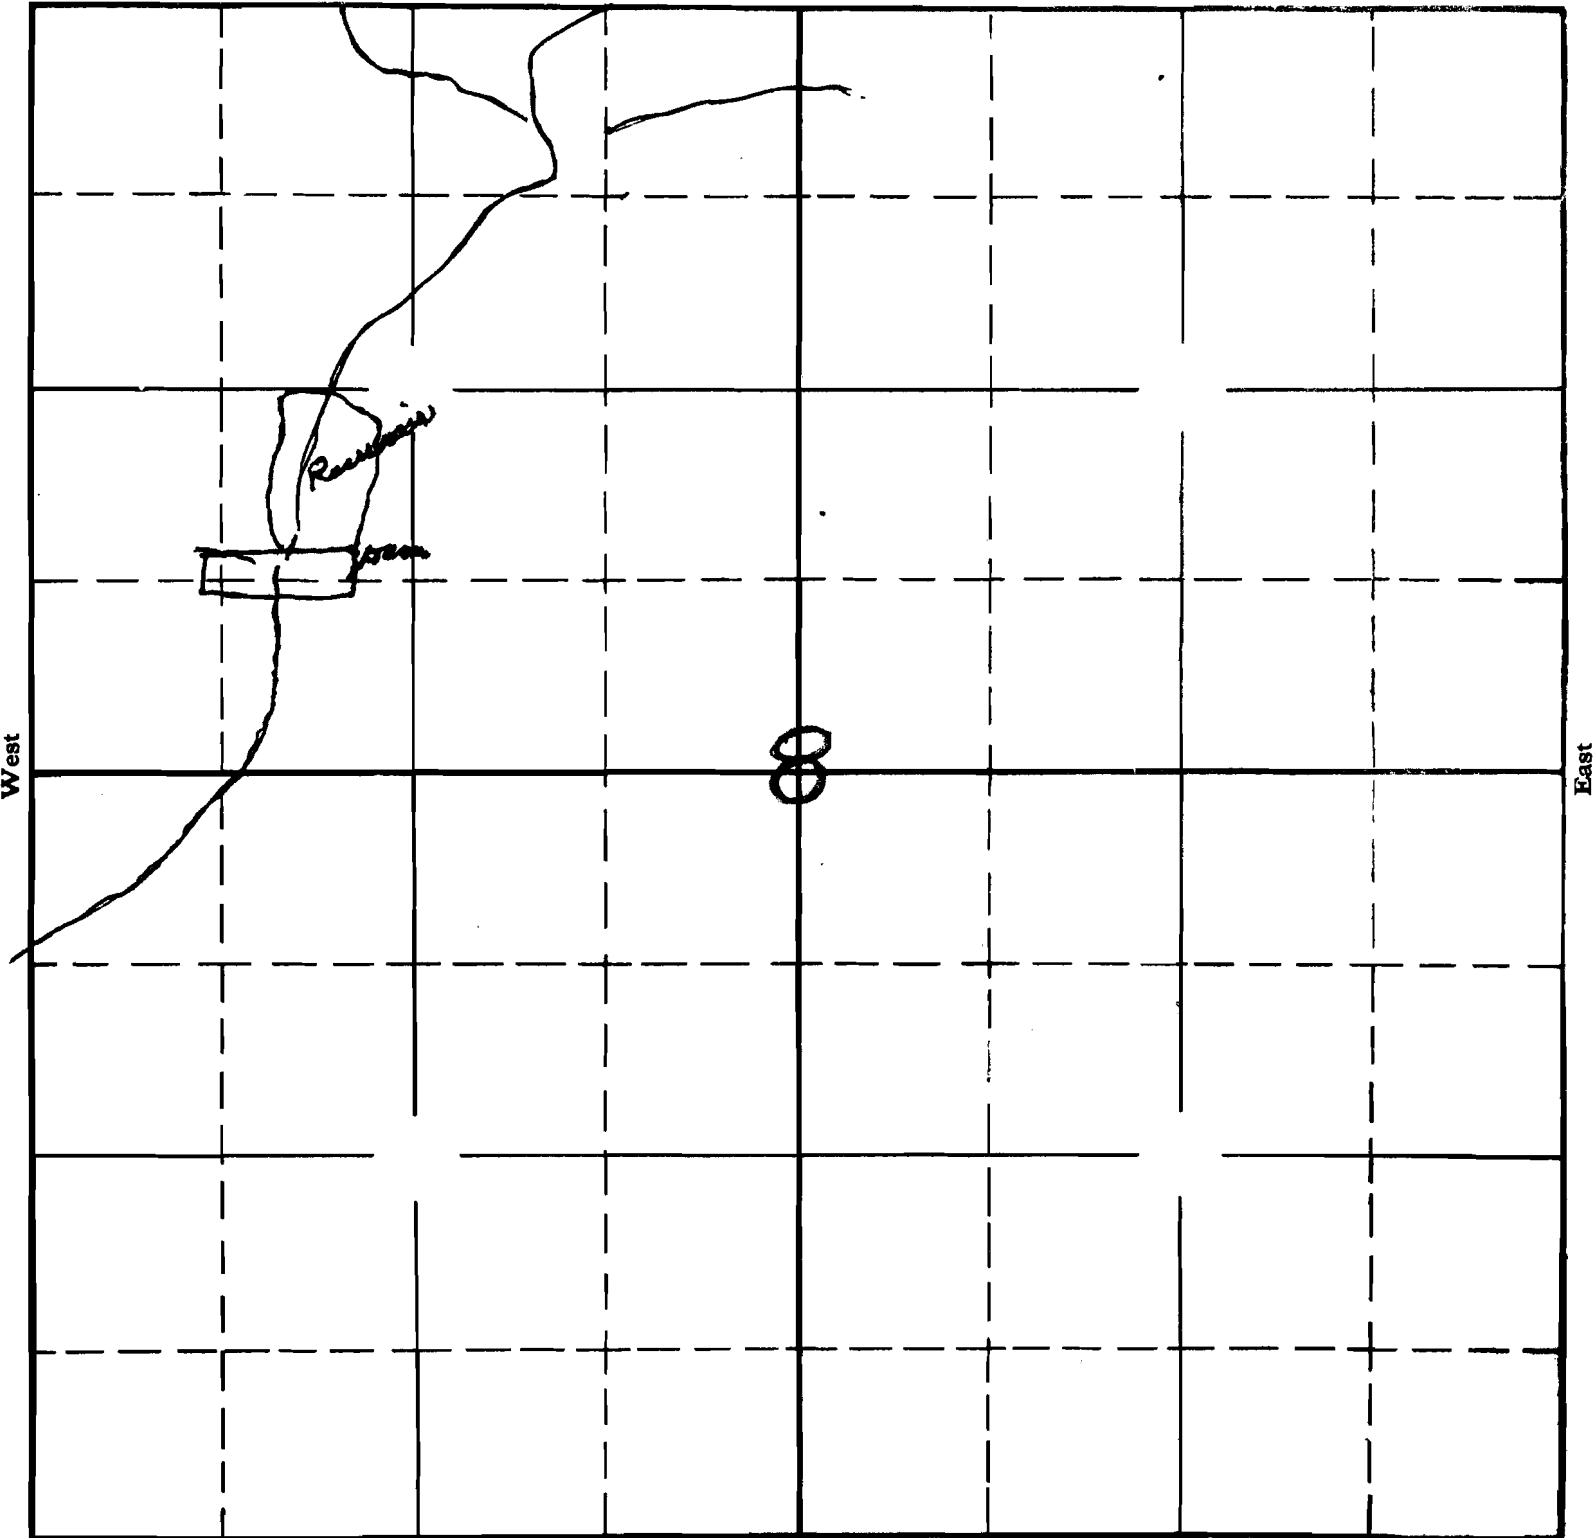

West

East

South

APPLICATION No. 15791
PERMIT No. R-679