


SECTION

TOWNSHIP 33S, RANGE 2E, W. M.

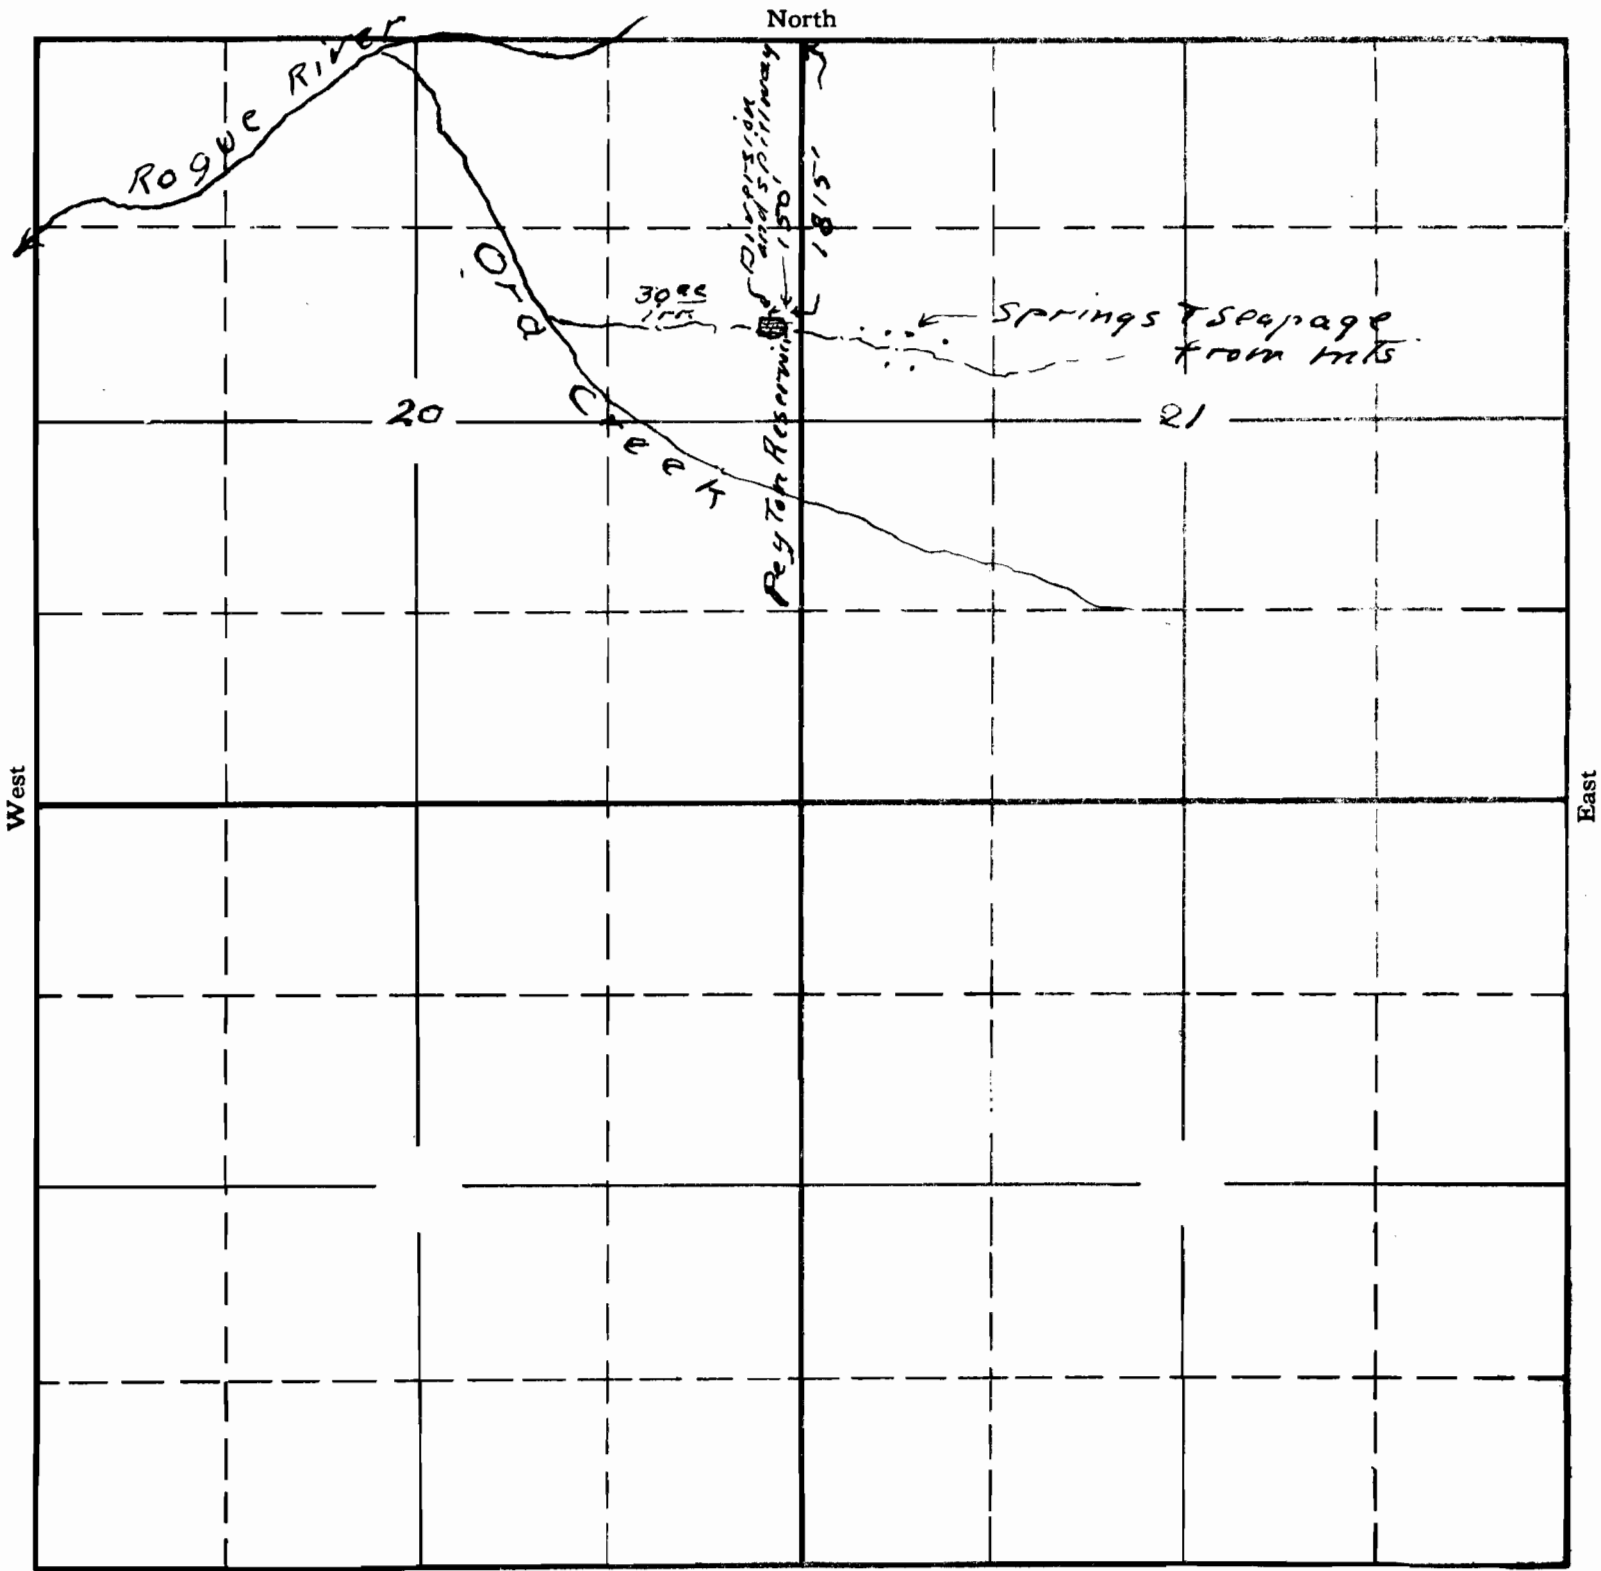

Map to accompany application of
 J E Peyton for reservoir or channel
 fed by springs Trip To Ora Creek

APPLICATION No. 15958
 PERMIT No. R-685