


SECTION

SUP TO PERMIT 5678

TOWNSHIP ³⁷⁵ 385, RANGE 2 E, W. M. NEW

North

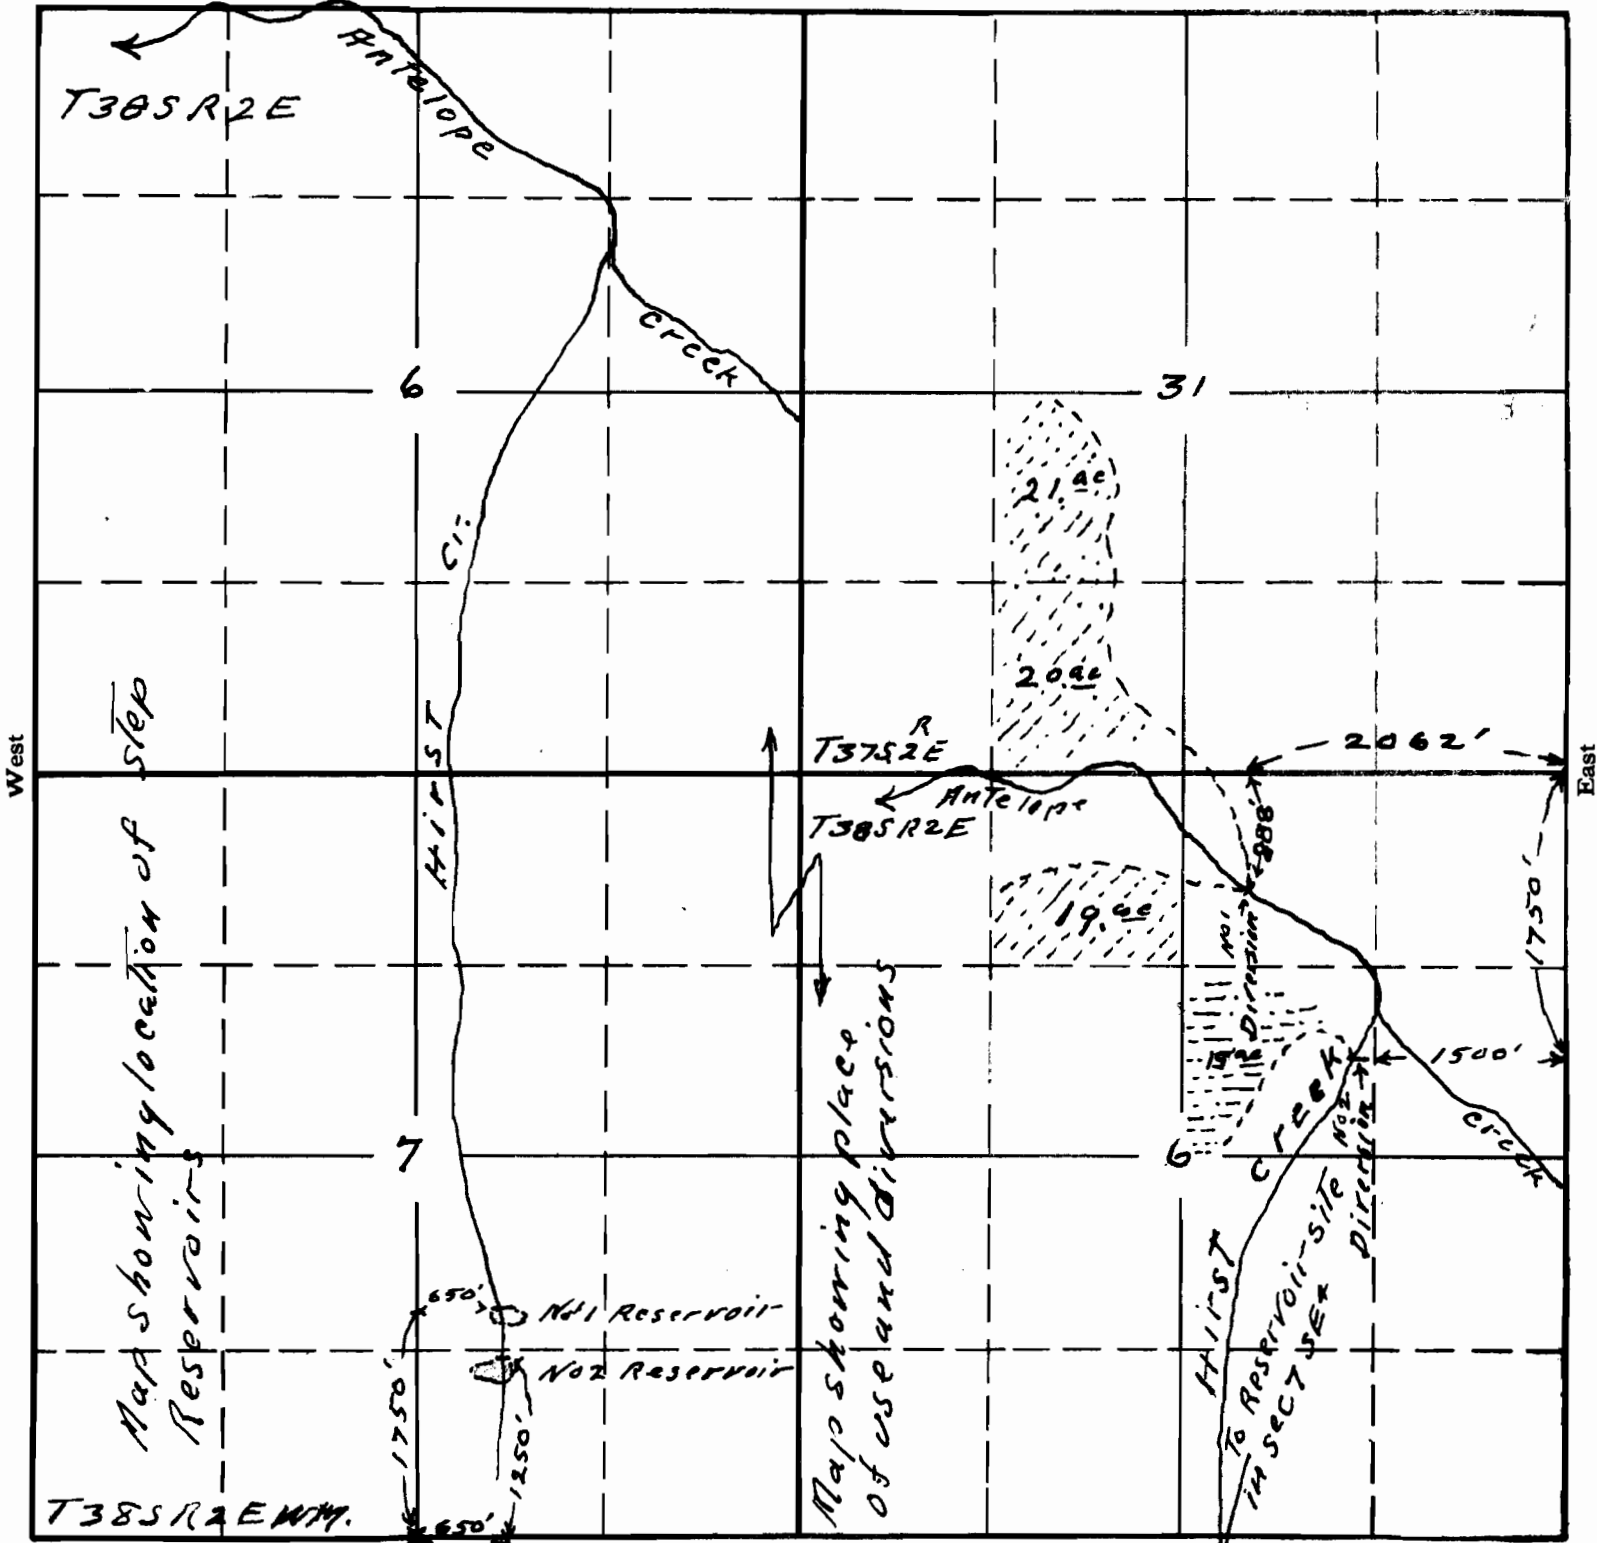

To accompany applications of L.H. VERTZ and Frank Hurst for Reservoirs and use, for irrigation purposes.

APPLICATION No. 16075

PERMIT No. 11903

App. No. 16074
Per. No. R-686