

UNITED STATES
DEPARTMENT OF THE INTERIOR
BUREAU OF LAND MANAGEMENT


SECTION

- 10
- 11
- 14
- 15

Oregon State Water Filings

TOWNSHIP 39S, RANGE 13E, W. M.

North

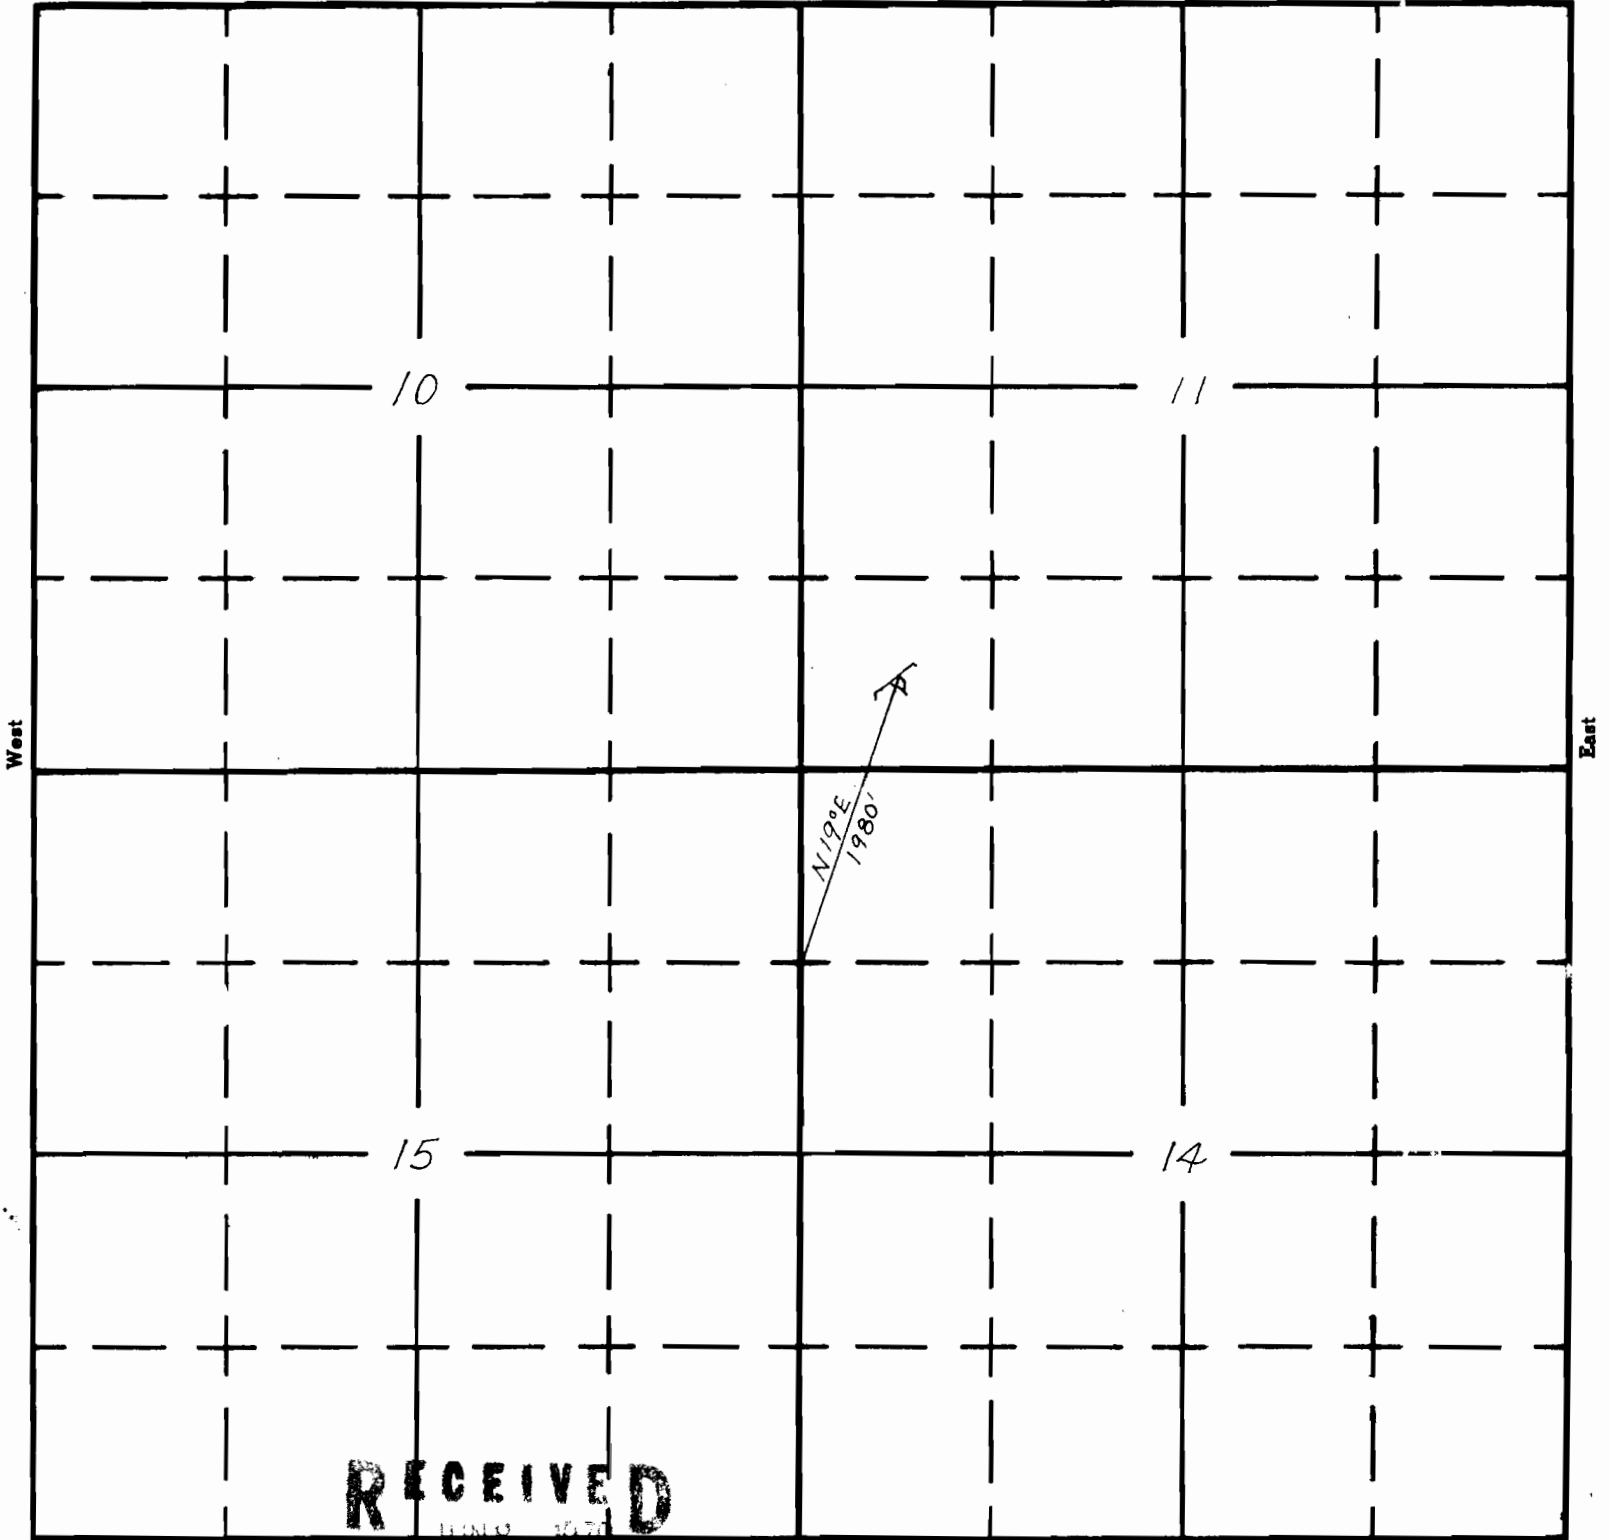

RECEIVED
JULY 1970

STATE ENGINEER
SALEM, OREGON

South

APPLICATION NO. R 47053
PERMIT NO. R 7398