



T 26 S. R. 3 W. W.M.

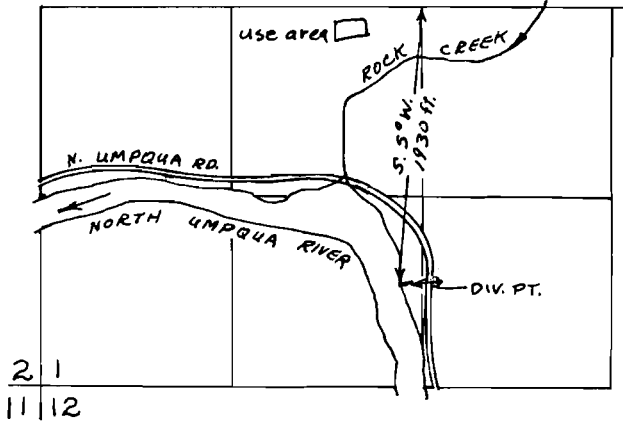

4" = 1 mile

APPLICATION MAP
 OREGON
 DEPT. OF FISH & WILDLIFE

APPLICATION - R-57860
 57861
 PERMIT - R 7734
 43627

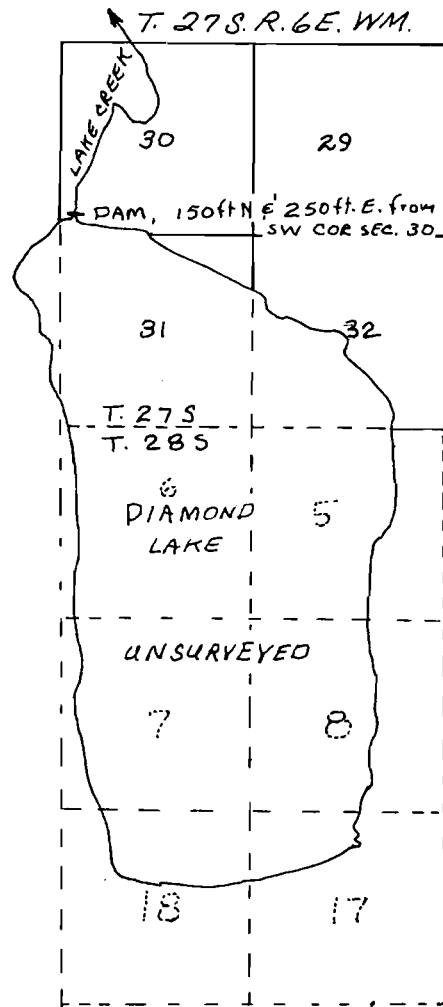

1" = 1 mile

1100