


T26S R12W
SE 1/4 SE 1/4
Sec 4

RECEIVED
OCT 20 1979

W E
Scale
1" = 400'

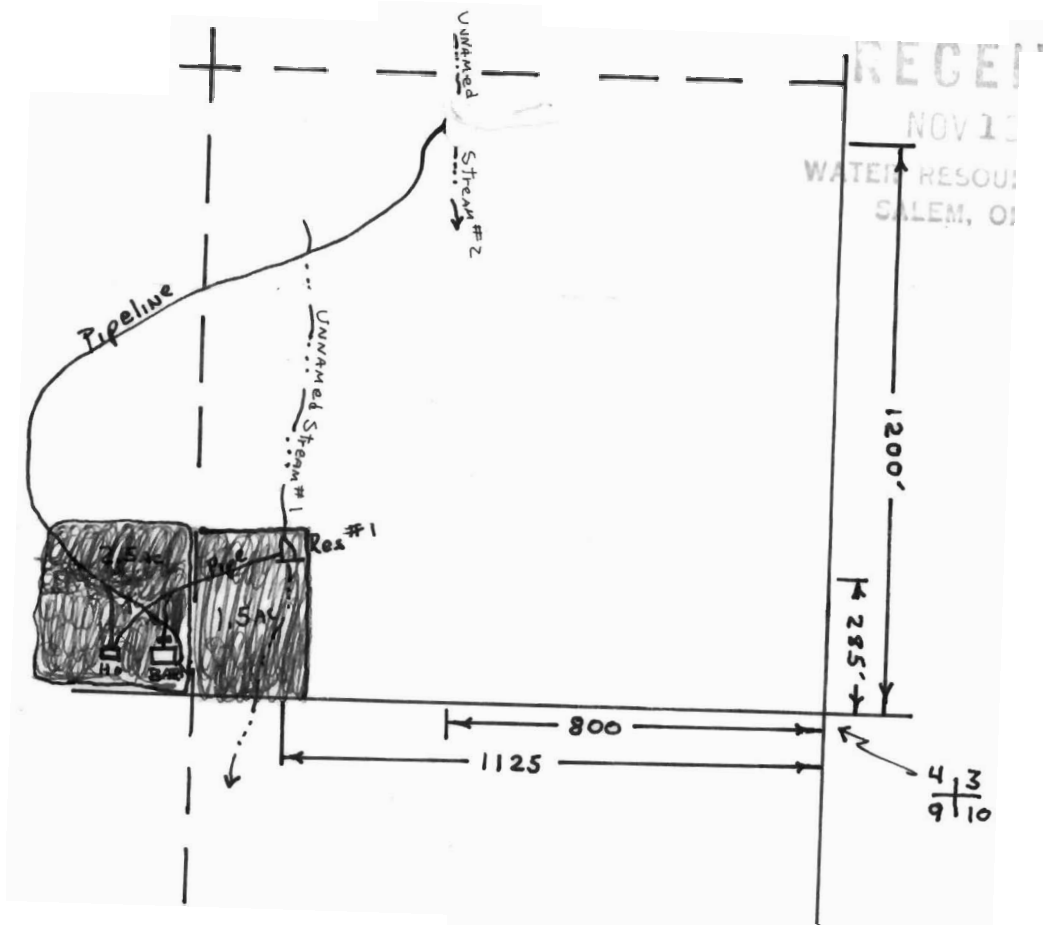

RECEIVED
JAN 25 1979
WATER RESOURCES DEPT.
SALEM, OREGON

Application No. 58268
Permit No. R 7967 44549

THIS MAP PREPARED BY: J. P. Brolet
FROM INFORMATION FURNISHED BY THE
APPLICANT.

RECEIVED
JUL - 2 1979
WATER RESOURCES DEPT.
SALEM, OREGON