


T.8S.,R.5W.,W.M.

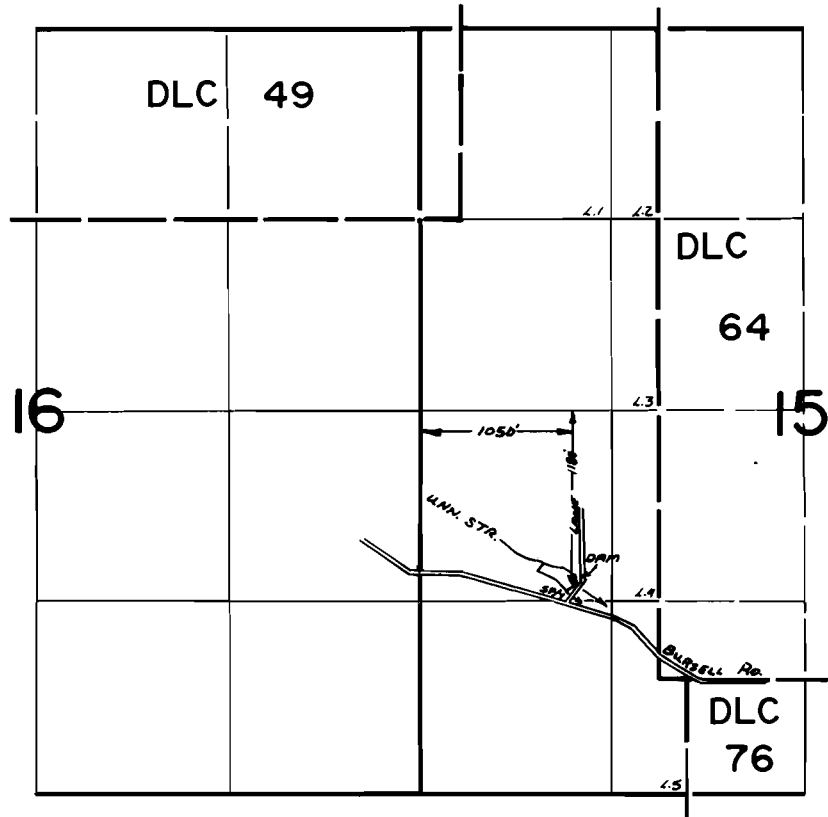

**FINAL PROOF SURVEY**  
UNDER

Application No. R-58913 Permit No. R-7978  
IN NAME OF

FRANK G. NELSON

Surveyed Sept. 11, 1981, by L. TOLL