


# T. 8 S., R. 3 W., W.M.

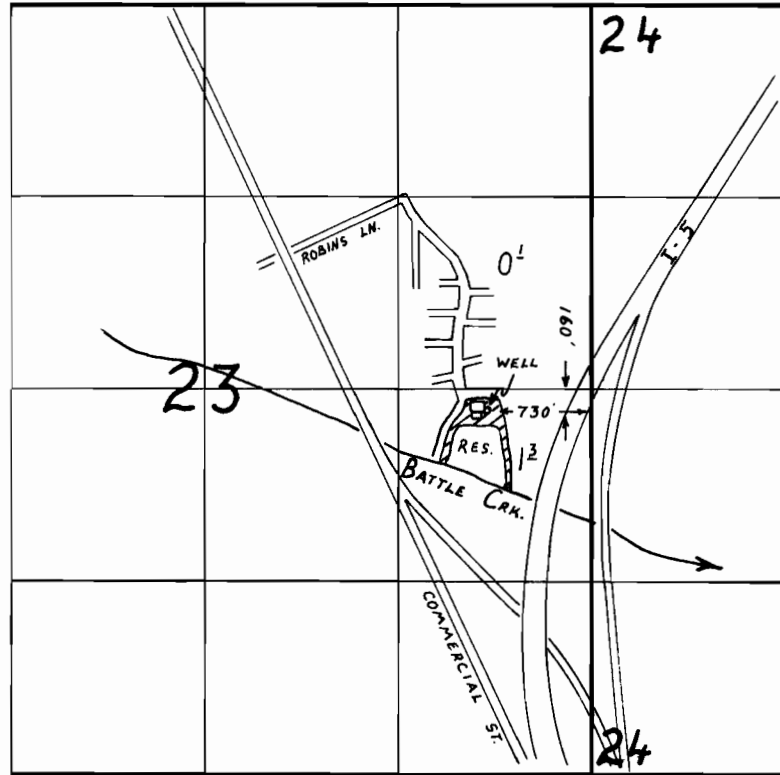

## FINAL PROOF SURVEY

UNDER

Application No. G-9103  
R-58231, 58240 Permit No. G-8792  
R-8098, 44724  
IN NAME OF

TERRACE LAKE

Surveyed AUGUST 17, 1992, by R.W. Klassen