

Application No.

60942 & R-60941
R 8199

Permit No.

TOWNSHIP 45, RANGE 2 E, W. M.
45292

RECEIVED

OCT 27 1980

WATER RESOURCES DEPT.
SALEM, OREGON

North

RECEIVED

MAR 30 1979


WATER RESOURCES DEPT.
SALEM, OREGON

Application No. 58470
Permit No. 44263

21

DWPT LOCATED 10 FT N.
and 200 FT E from
N $\frac{1}{4}$ corner section 28

660' South From
570' East corner
pond

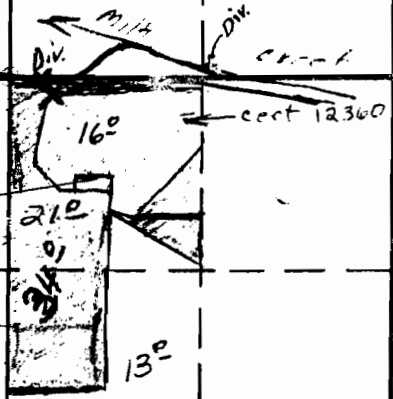

28

South

APPLICATION No. 15993

PERMIT No. 71816