


RECEIVED

AUG 28 1980

WATER RESOURCES DEPT
SALEM, OREGON

T.2 N. R. 4 W.W.M.

Scale 4" = 1 mile

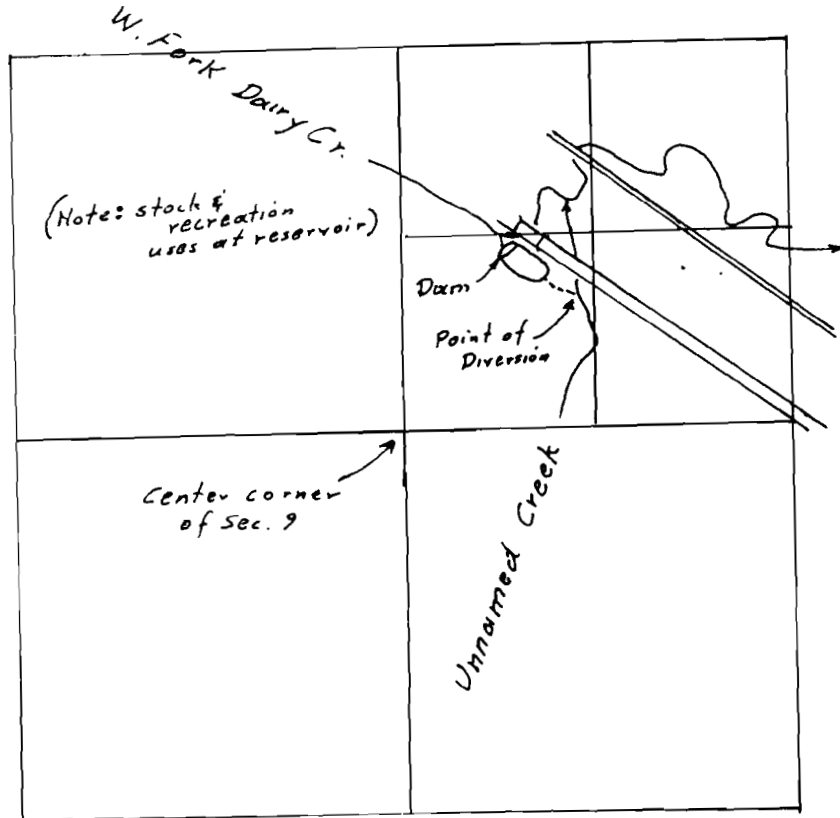

Dam located: 1250 ft. N. & 700 ft. E from
the center corner of Sec. 9

Point of Diversion on Creek located:
925 ft. N. & 1200 ft. E. from the
center corner of Sec. 9

Application No. 60567
Permit No. 45700

R-60566
R 8257