

SECTION


14

TOWNSHIP 30 S, RANGE 5 W, W. M.

North

West

East

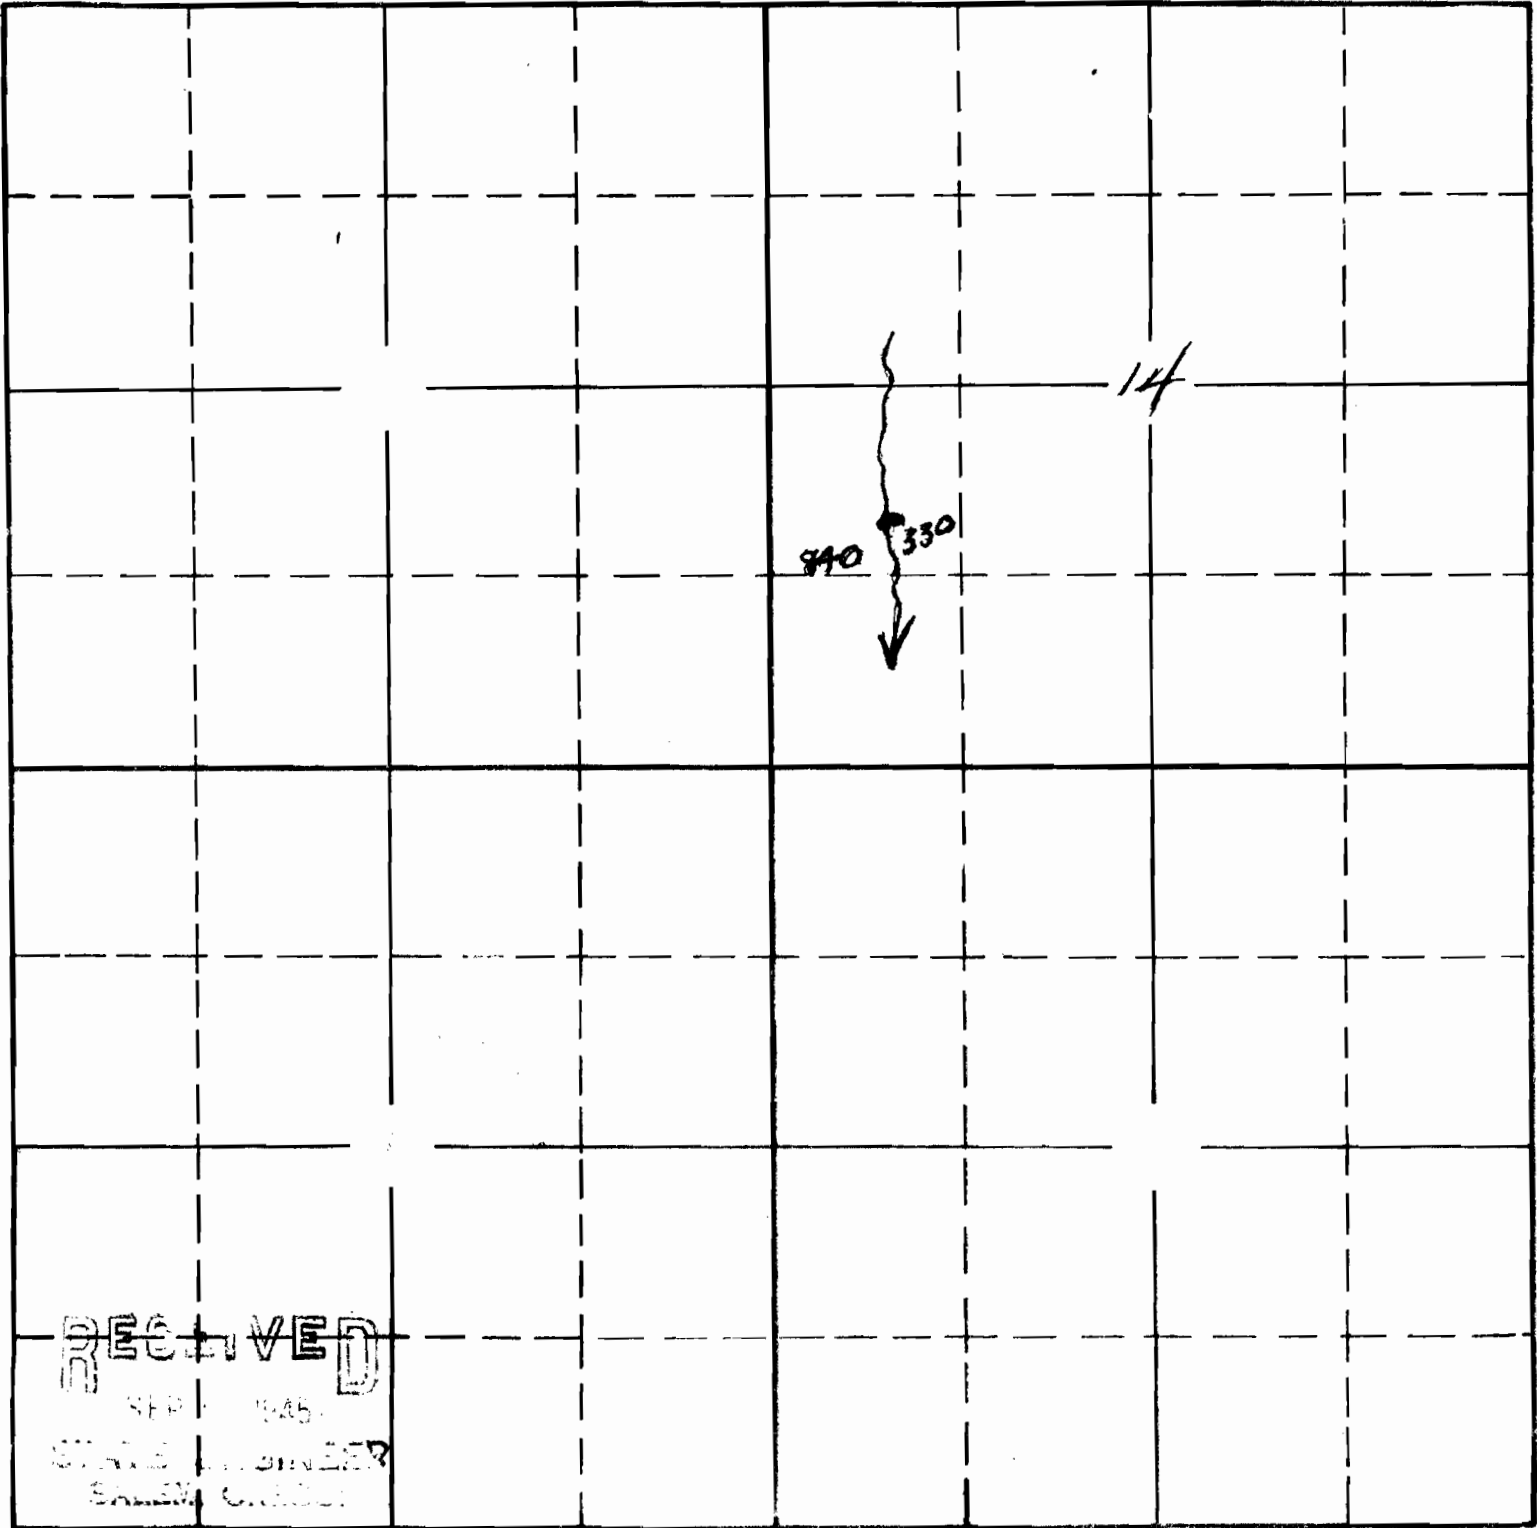

RECEIVED

SEP 1 1945

STATE ENGINEER
SALEM, OREGON

South

21158 R-21157
16-36

APPLICATION No. 21157

PERMIT No. R-827
16579