


Application No. 60606  
Permit No. 46067

Section 9 T.34.5 R.5 W.W.M  
Josephine County  
R# 400'

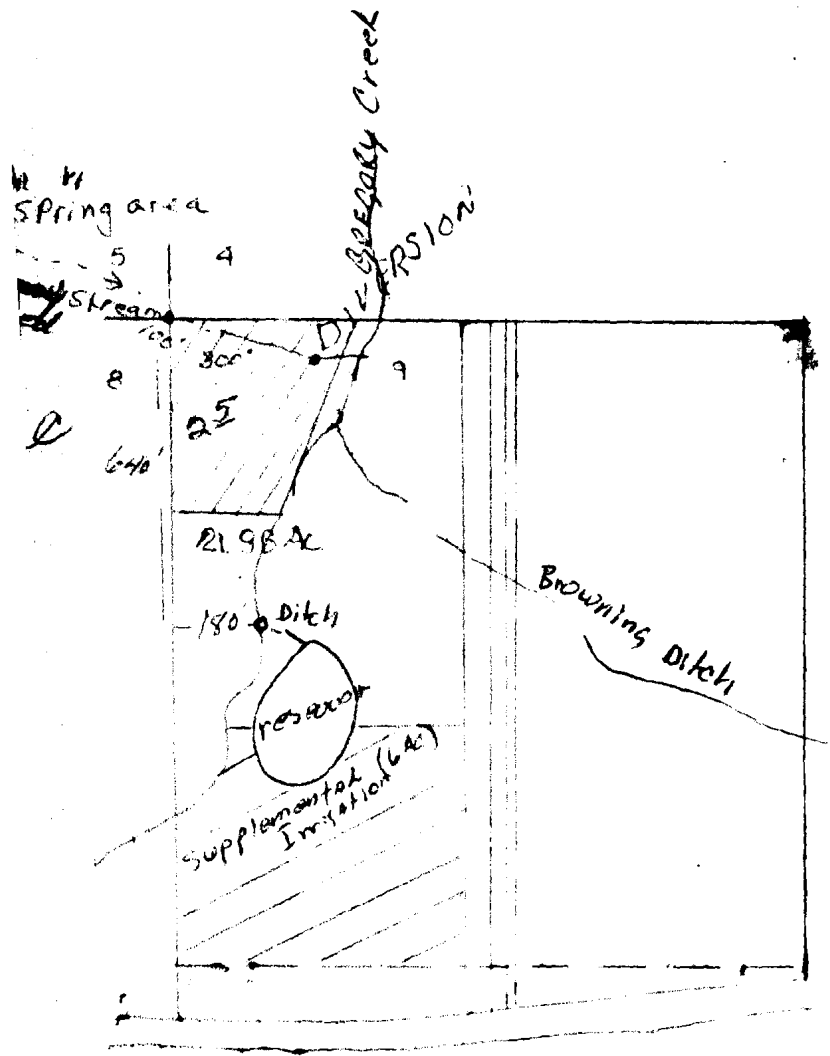

RECEIVED  
SEP 09 1980  
WATER RESOURCES DEPT  
SALEM, OREGON

RECEIVED  
SEP 11 1980  
WATER RESOURCES DEPT  
SALEM, OREGON