


# MEYER

DUANE CULBERTSON, MANAGER

*Supervisor*  
5/24/82

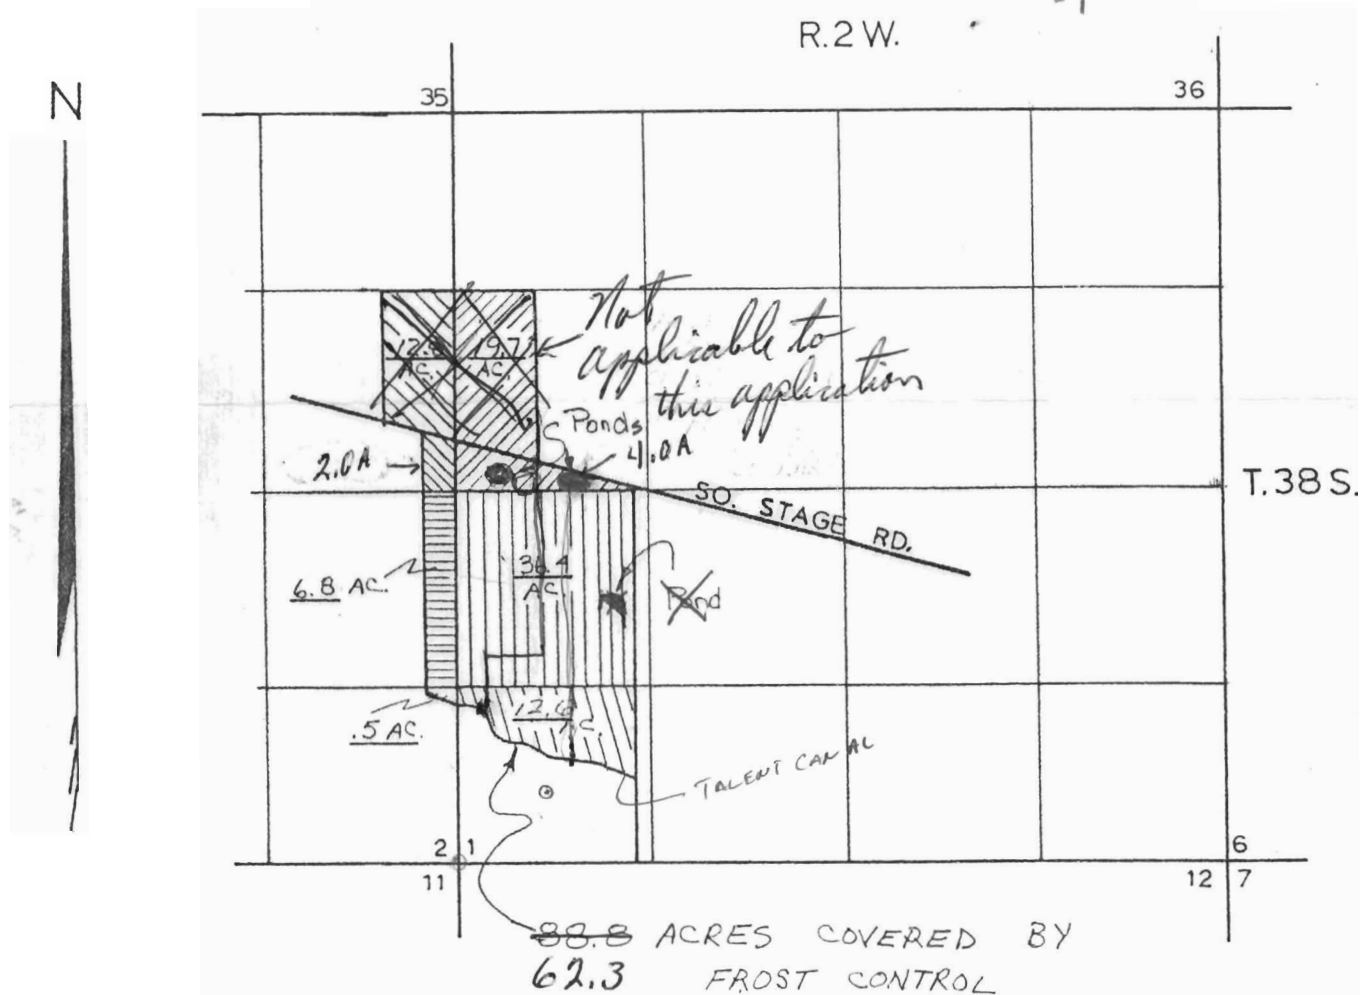

SCALE: 1 MILE = 4.0"

Application No. 62821  
Permit No. 46597

**RECEIVED**  
SEP 22 1981  
WATER RESOURCES DEPT  
SALEM, OREGON


**RECEIVED**  
MAY 24 1982

3-79, J. BOVA - U.S.D.A., S.C.S.

WATER RESOURCES DEPT  
SALEM, OREGON

MEYER ORCHARD

Duane Culbertson, Manager

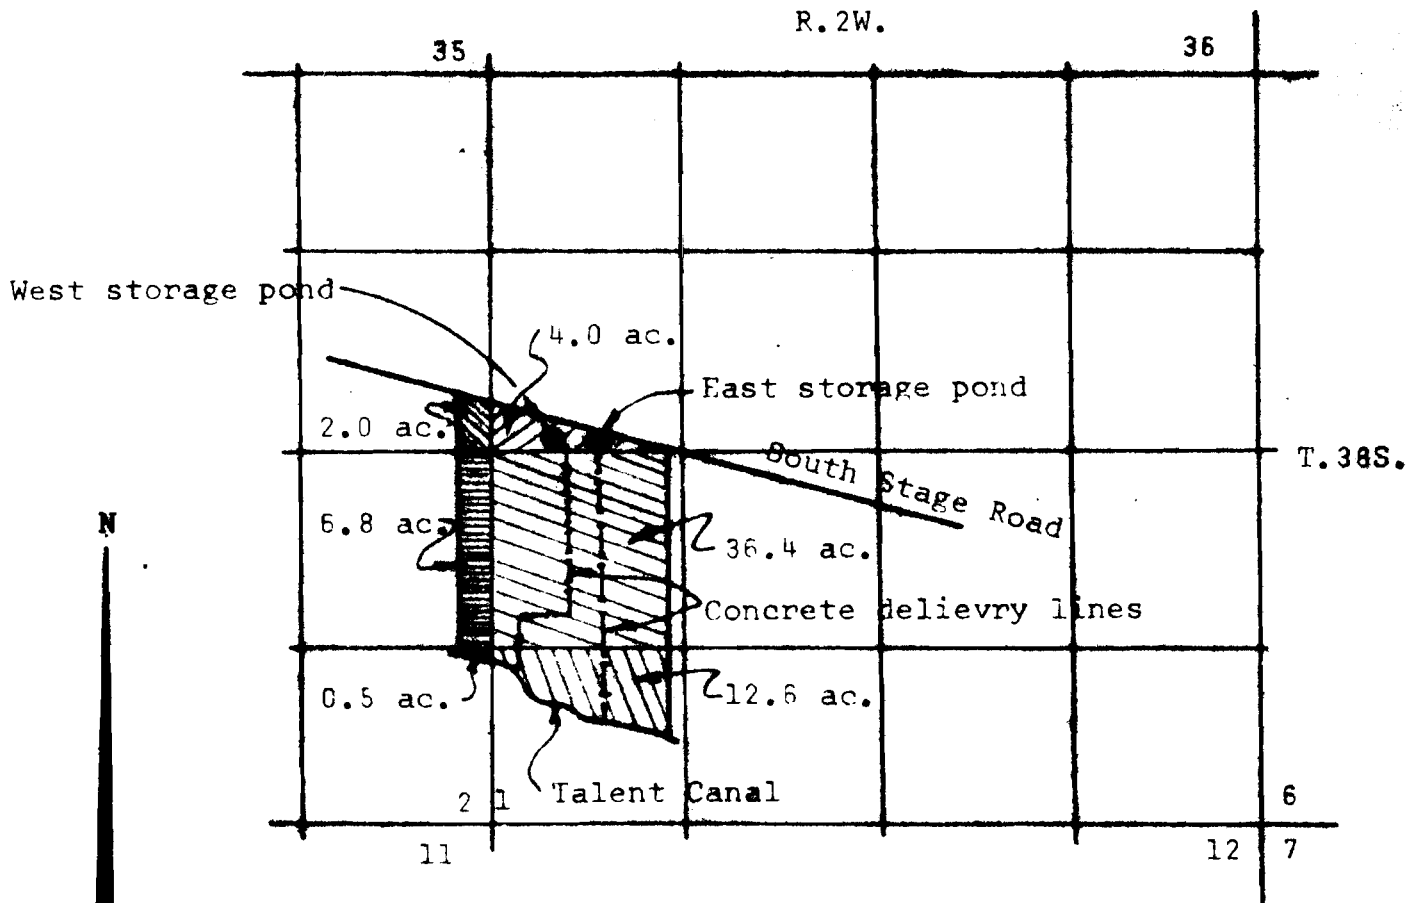

Total acres covered by Frost Control is 62.3

Scale 4" = 1 mile

Application No. R 8390

46597

MAILED 2  
WATER RESOURCES DEPT  
SALE OF OREGON

Revised 5/19/82