


Permit: R 8398
Volume: 5
Strm: LOUSE CR
Trib: JUMPOFF JOE CR
Priority: 11/09/81

T. 35 S., R. 5 W., W.....

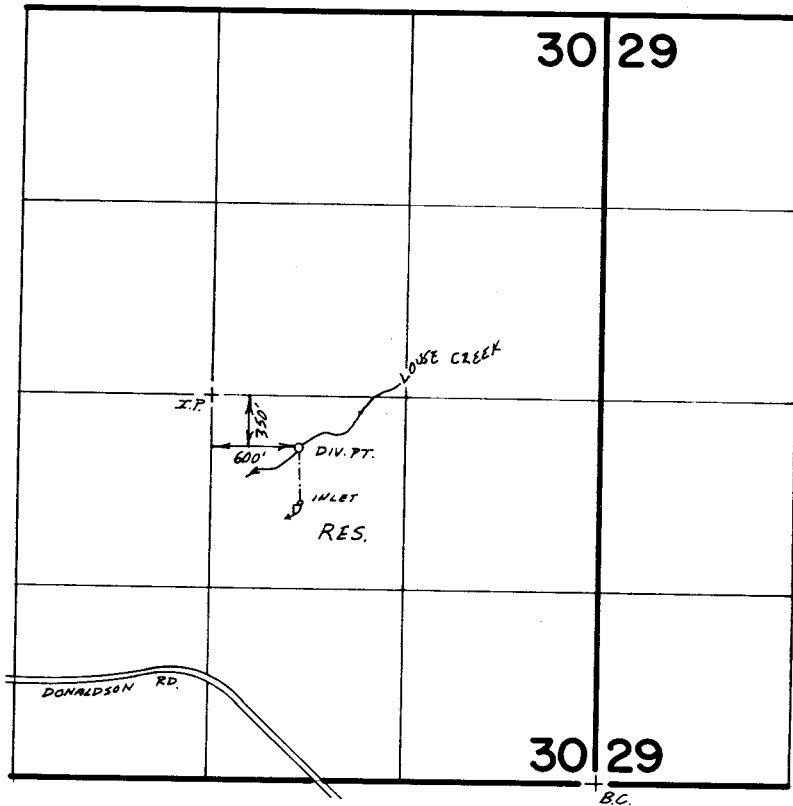

Scale 1" = 1320'

FINAL PROOF SURVEY UNDER

Transfer No. 4705

R-63035

R-8398 - Cert. 73982

Application No. ~~63209~~ Permit No. 46665.....

IN NAME OF

.....
Surveyed July 10, 1984, by B.S. JAMES.....