


T 30S R15W
Sec 11

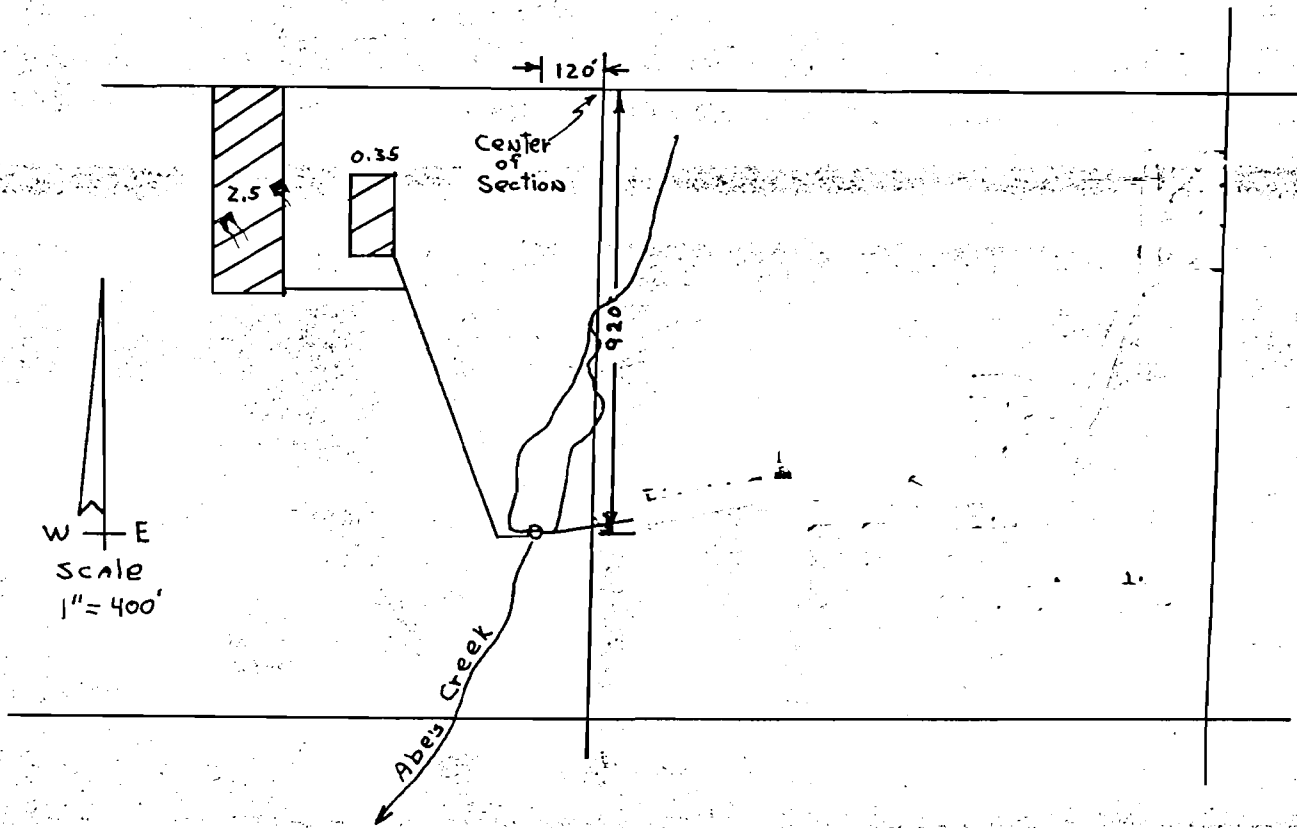

Application No. R-61485 & 61486
Permit No. R 8453 46813

RECEIVED
JUL 20 1982
WATER RESOURCES DEPT.
SALEM, OREGON

RECEIVED
MAY 8 1982
WATER RESOURCES DEPT
SALEM, OREGON

RECEIVED
MAR 21 1981
WATER RESOURCES DEPT
SALEM, OREGON