


33

TOWNSHIP 37S, RANGE 2W, W. M.

North

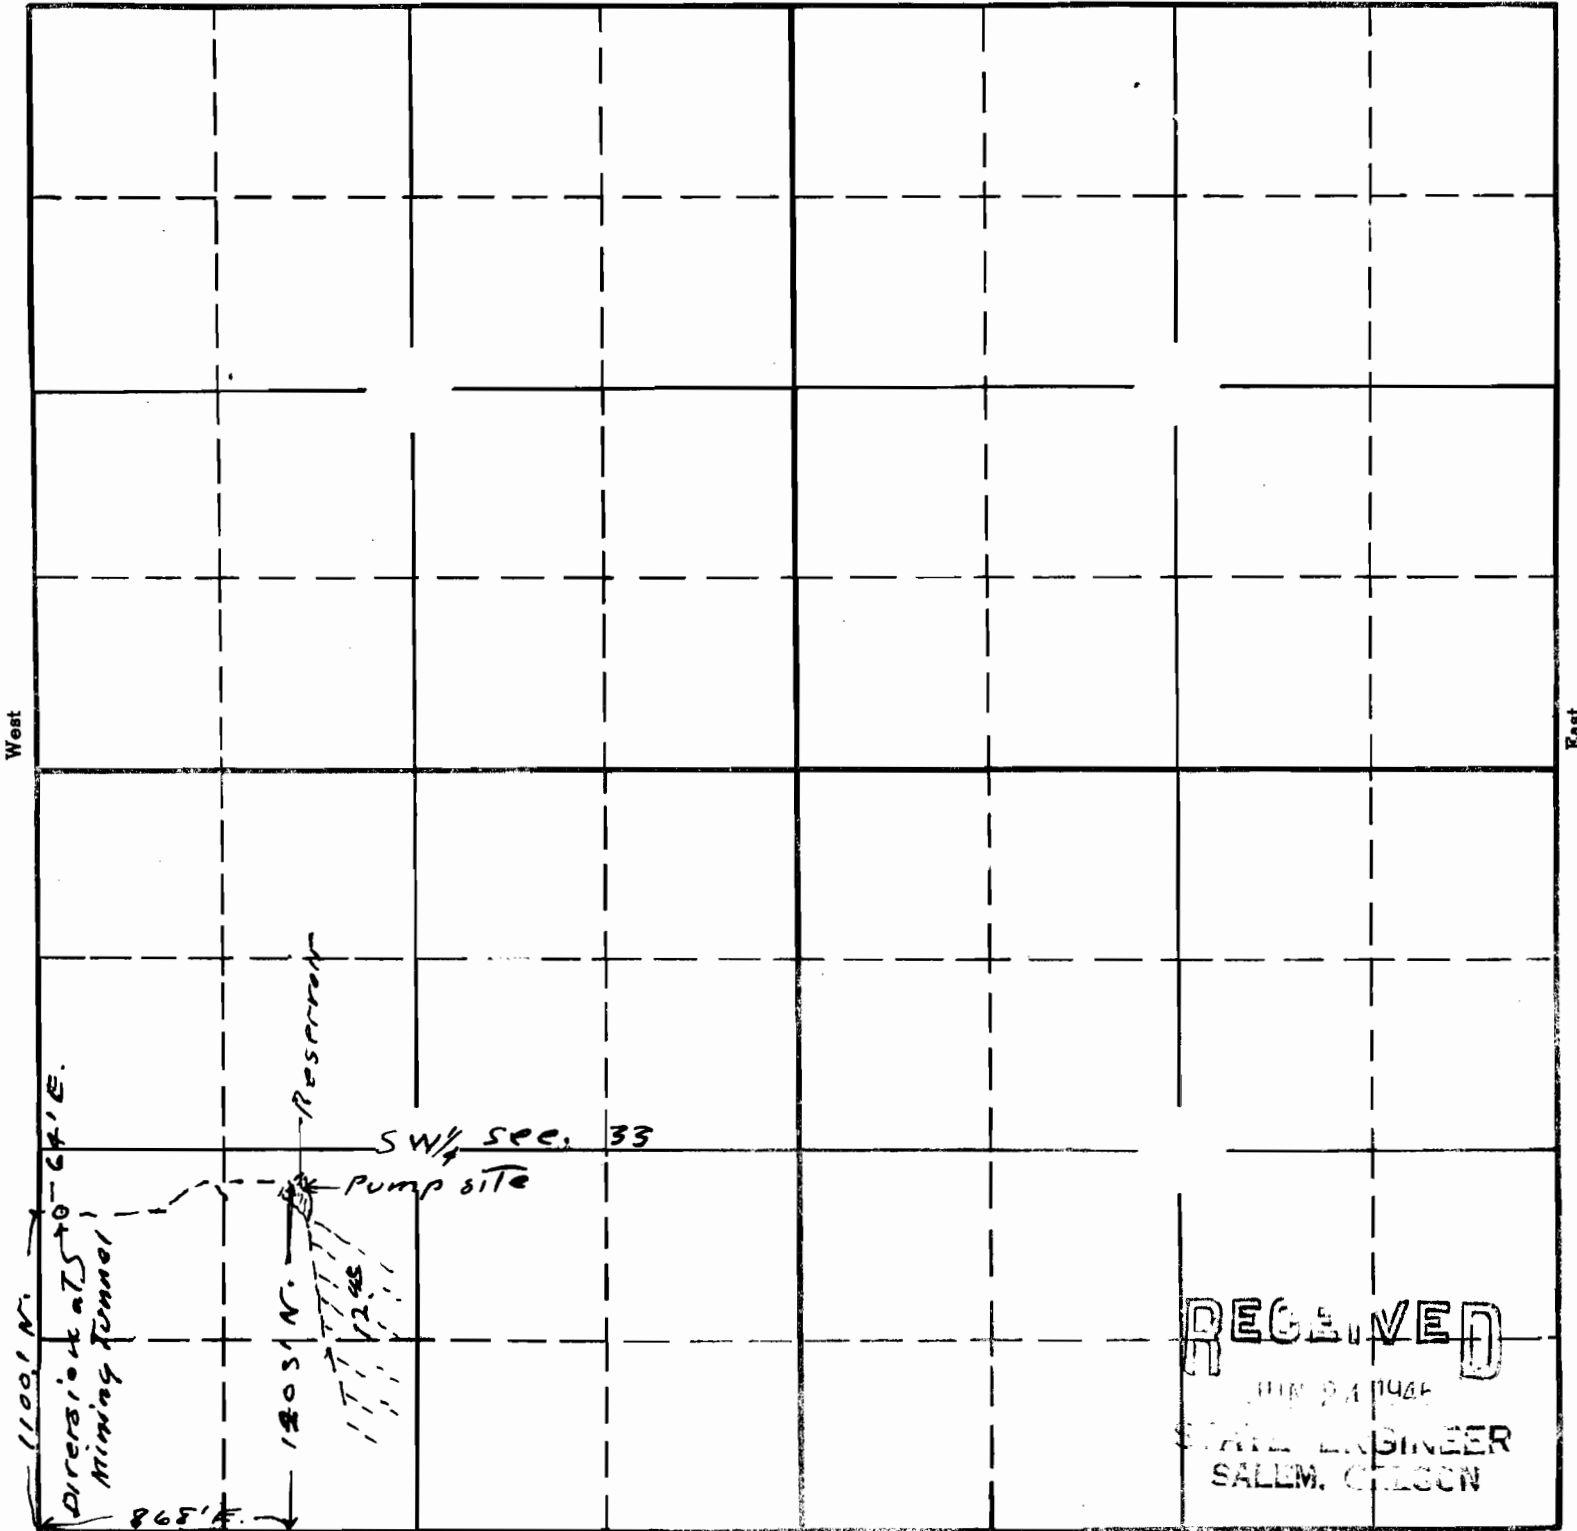

**RECEIVED**  
 JUL 24 1946  
 STATE ENGINEER  
 SALEM, OREGON

South

R-21753

15-24

Map to accompany application of  
 Roy V Martin for use of waters from  
 Mining Tunnel for storage

APPLICATION No. R-21753

PERMIT No. R-846

This office 6/18/46 *Smith*