

SECTION 8 T 9 S. R 1 E

8 9 1 E

MARION COUNTY  
Scale 1" = 400'


See Map 5 9 1 E

2 0 9 1 0 8 0

RECEIVED  
JUN 25 1982  
WATER RESOURCES DEPT.  
SALEM, OREGON

WARNING  
THIS MAP IS BASED UPON INFORMATION  
FURNISHED BY LOCAL SURVEYORS AND INFORMATION  
OBTAINED FROM PUBLIC RECORDS. THIS  
INFORMATION HAS NOT BEEN CHECKED BY MARION  
COUNTY FOR ACCURACY. MARION COUNTY  
ASSUMES NO LIABILITY FOR ANY  
INACCURACIES WHICH MAY BE PRESENT IN THIS  
MAP. USERS OF THIS MAP SHOULD THEMSELVES  
CHECK ANY MATTERS FOR ACCURACY BEFORE RELY-  
ING THEREON.

Application No. R-63707 &  
63708  
Permit No. 8469 46884

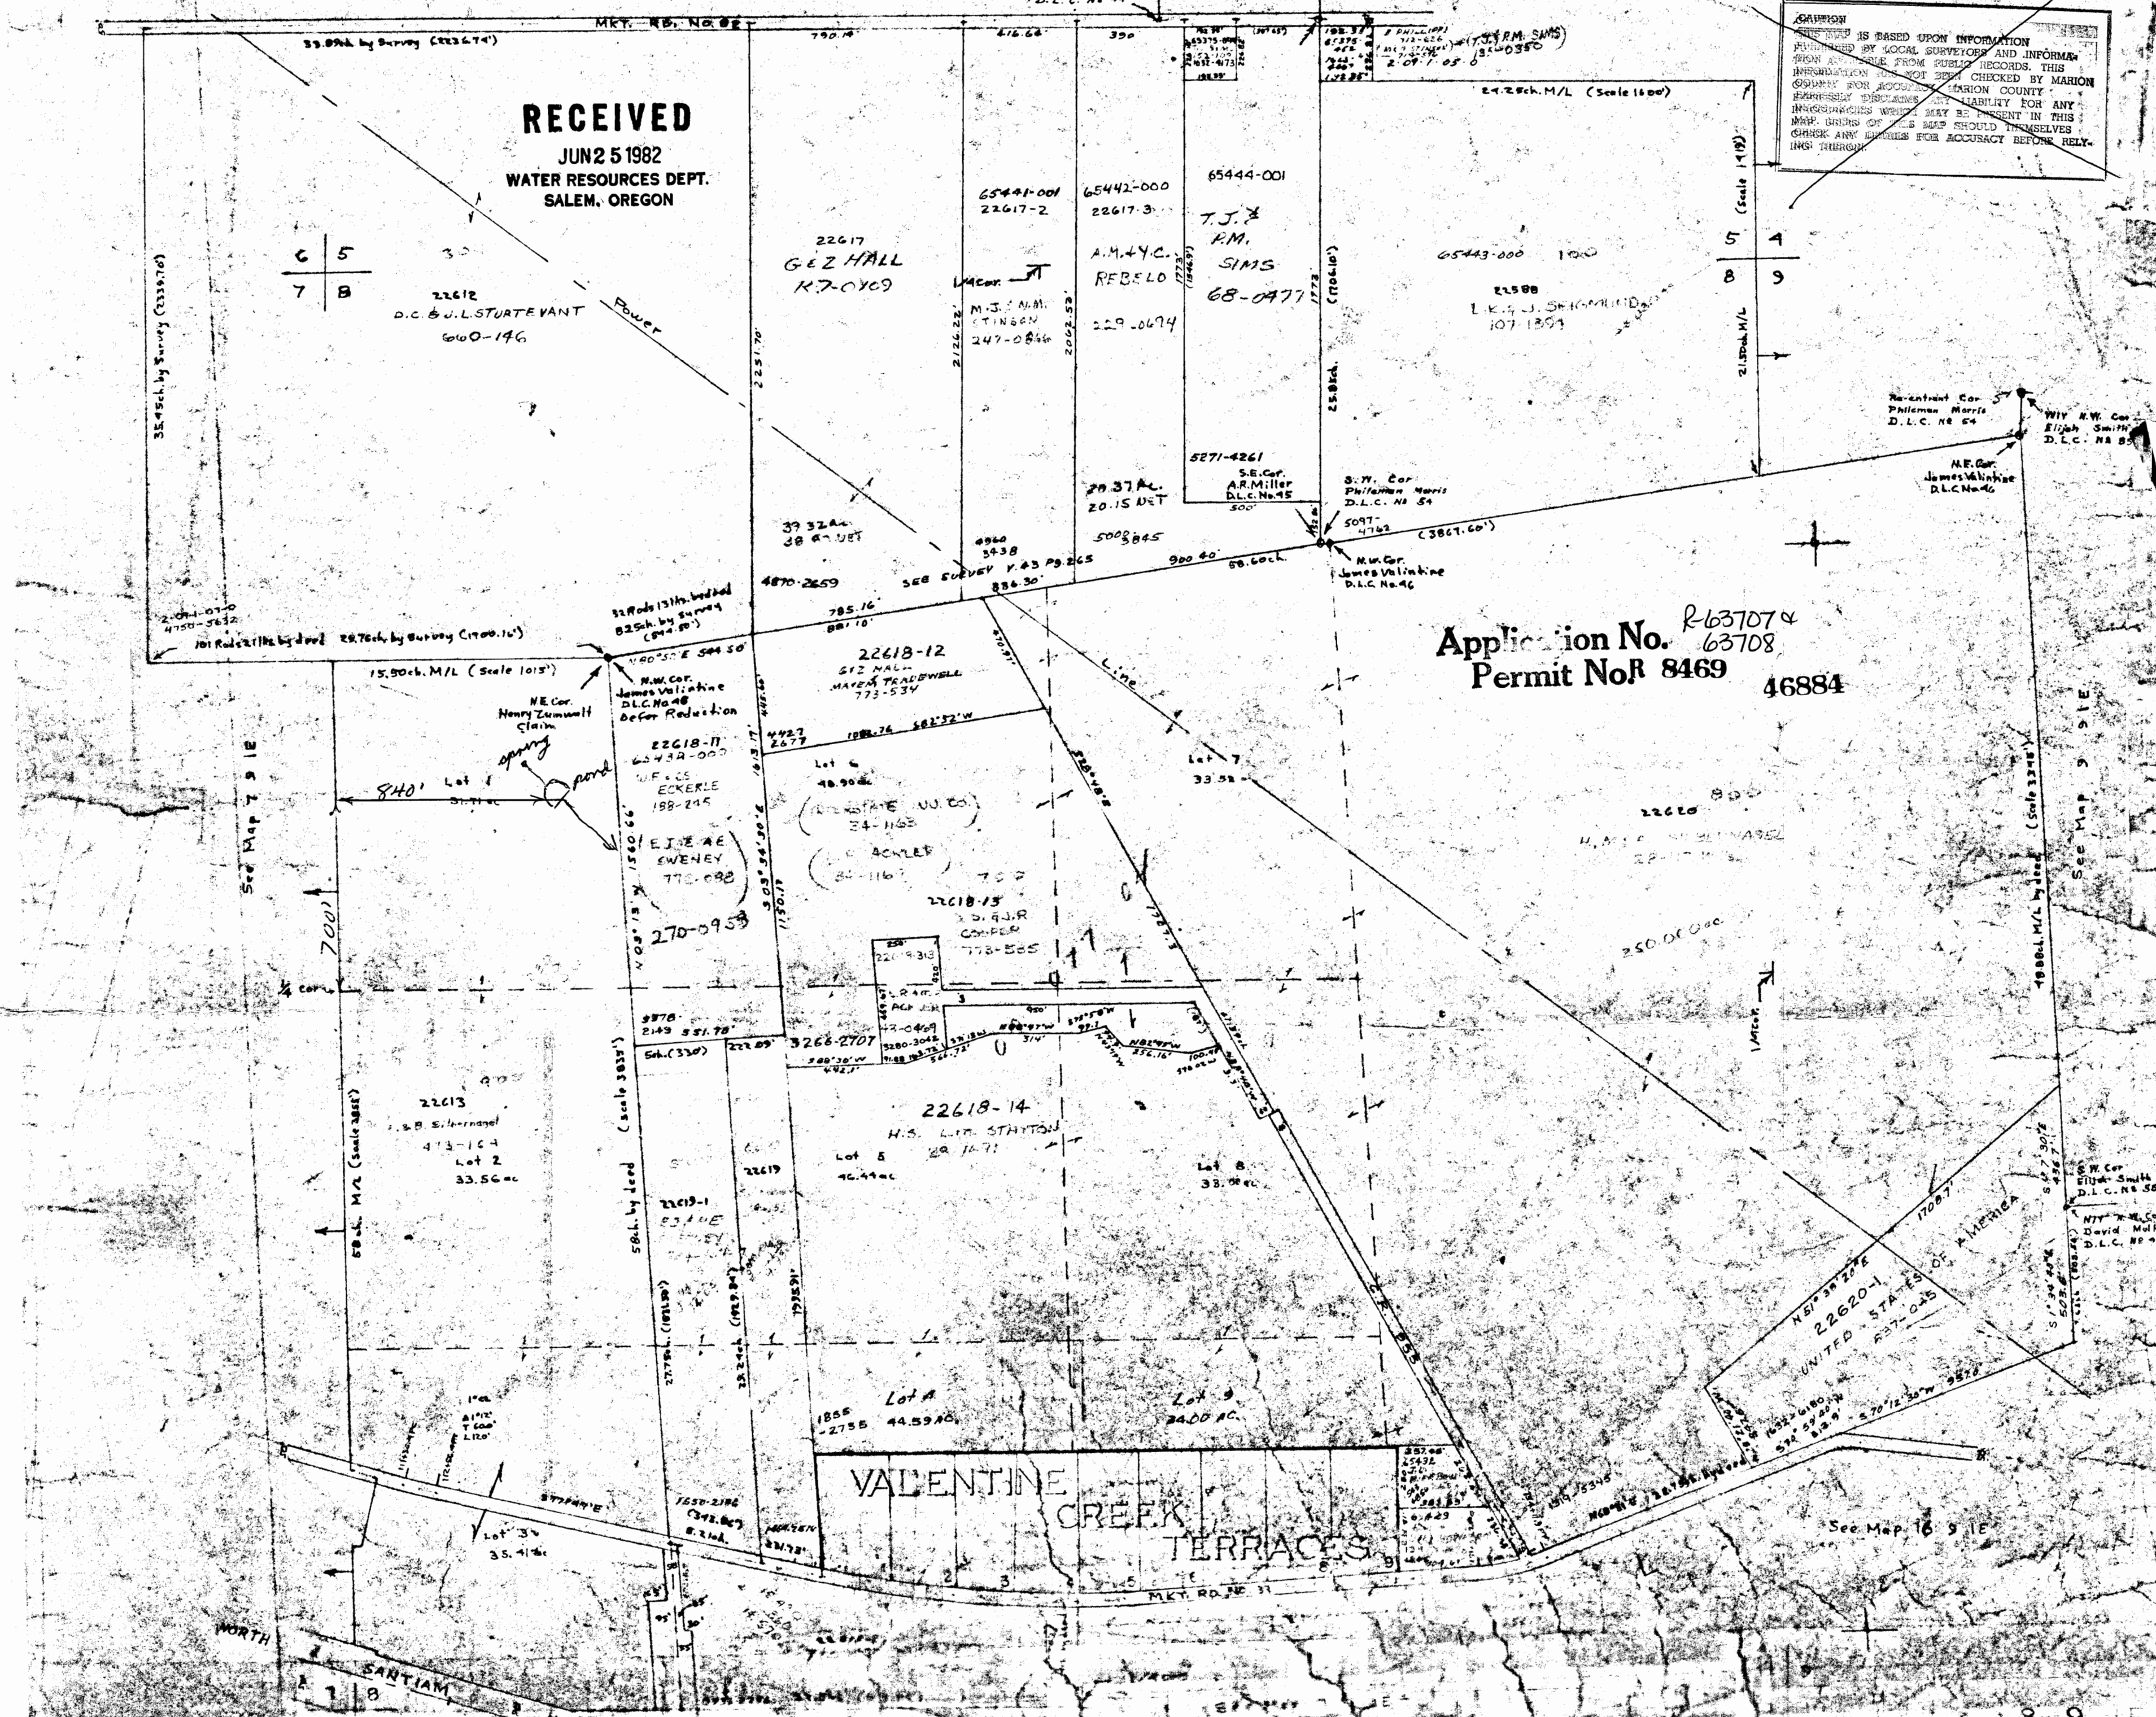

C 5  
7 B

5 4  
8 9

See Map 7 9 1 E

See Map 9 1 E

See Map 16 9 1 E

NORTH  
SANTIAM HWY

VALENTINE CREEK TERRACES