

RECEIVED

AUG 23 1982

WATER RESOURCES DEPT.
SALEM, OREGON

BOB CHRISTIANSEN
Route 1, Box 905
Bandon, OR 97411


REG ED

JUL 21 1982

WATER RESOURCES DEPT
SALEM, OREGON

T29S R14W

Application No. G-10765, R-63722 & 63723
Permit No. G 9860 R 8483 46952

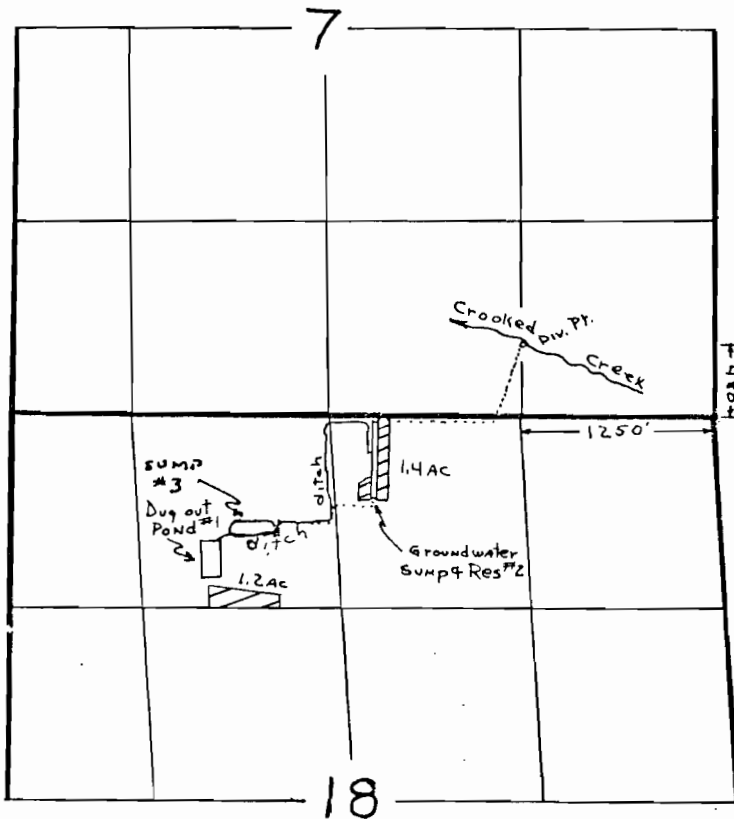

P.O.D.'s

Crooked Cr	480' N	1250' W	} from NE cor Sec 18
Dug out pond #1	1120' S	3440' W	
Sump/Res #2	600' S	2300' W	

THIS MAP PREPARED BY: J.P. Drolet, Coquille Field Office
FROM INFORMATION FURNISHED BY THE
APPLICANT.