


T. 35 S., R. 4 W., W.M.

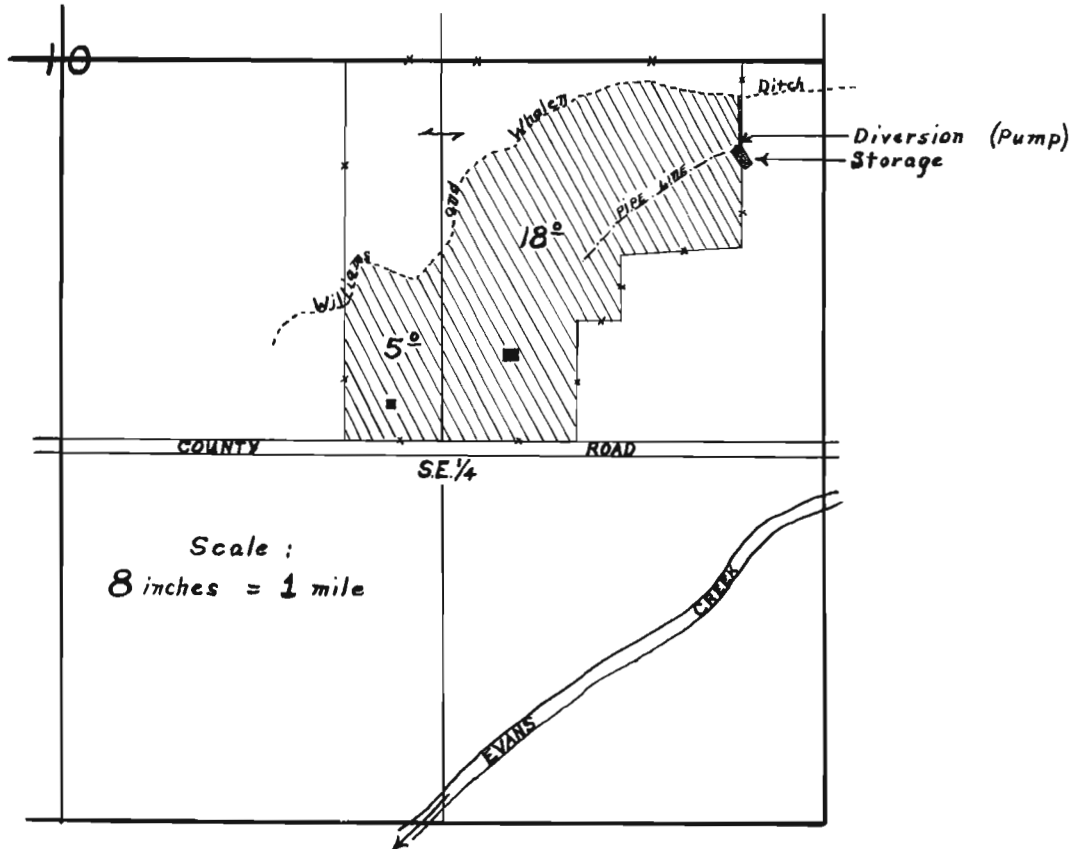

Map to accompany final proofs of  
Ralph W. Badcock, for use of water  
from Storage for Supplemental  
Irrigation purposes.

Application Nos. 2423B  
R-21921  
Permit Nos. 19037  
R-849

Plane table survey - Made April 8, 1955


David C. Hendrix, Watermaster

RECEIVED  
MAY 13 1955  
STATE ENGINEER  
SALEM, OREGON

10

TOWNSHIP 35 S, RANGE 4 W, W. M.

North

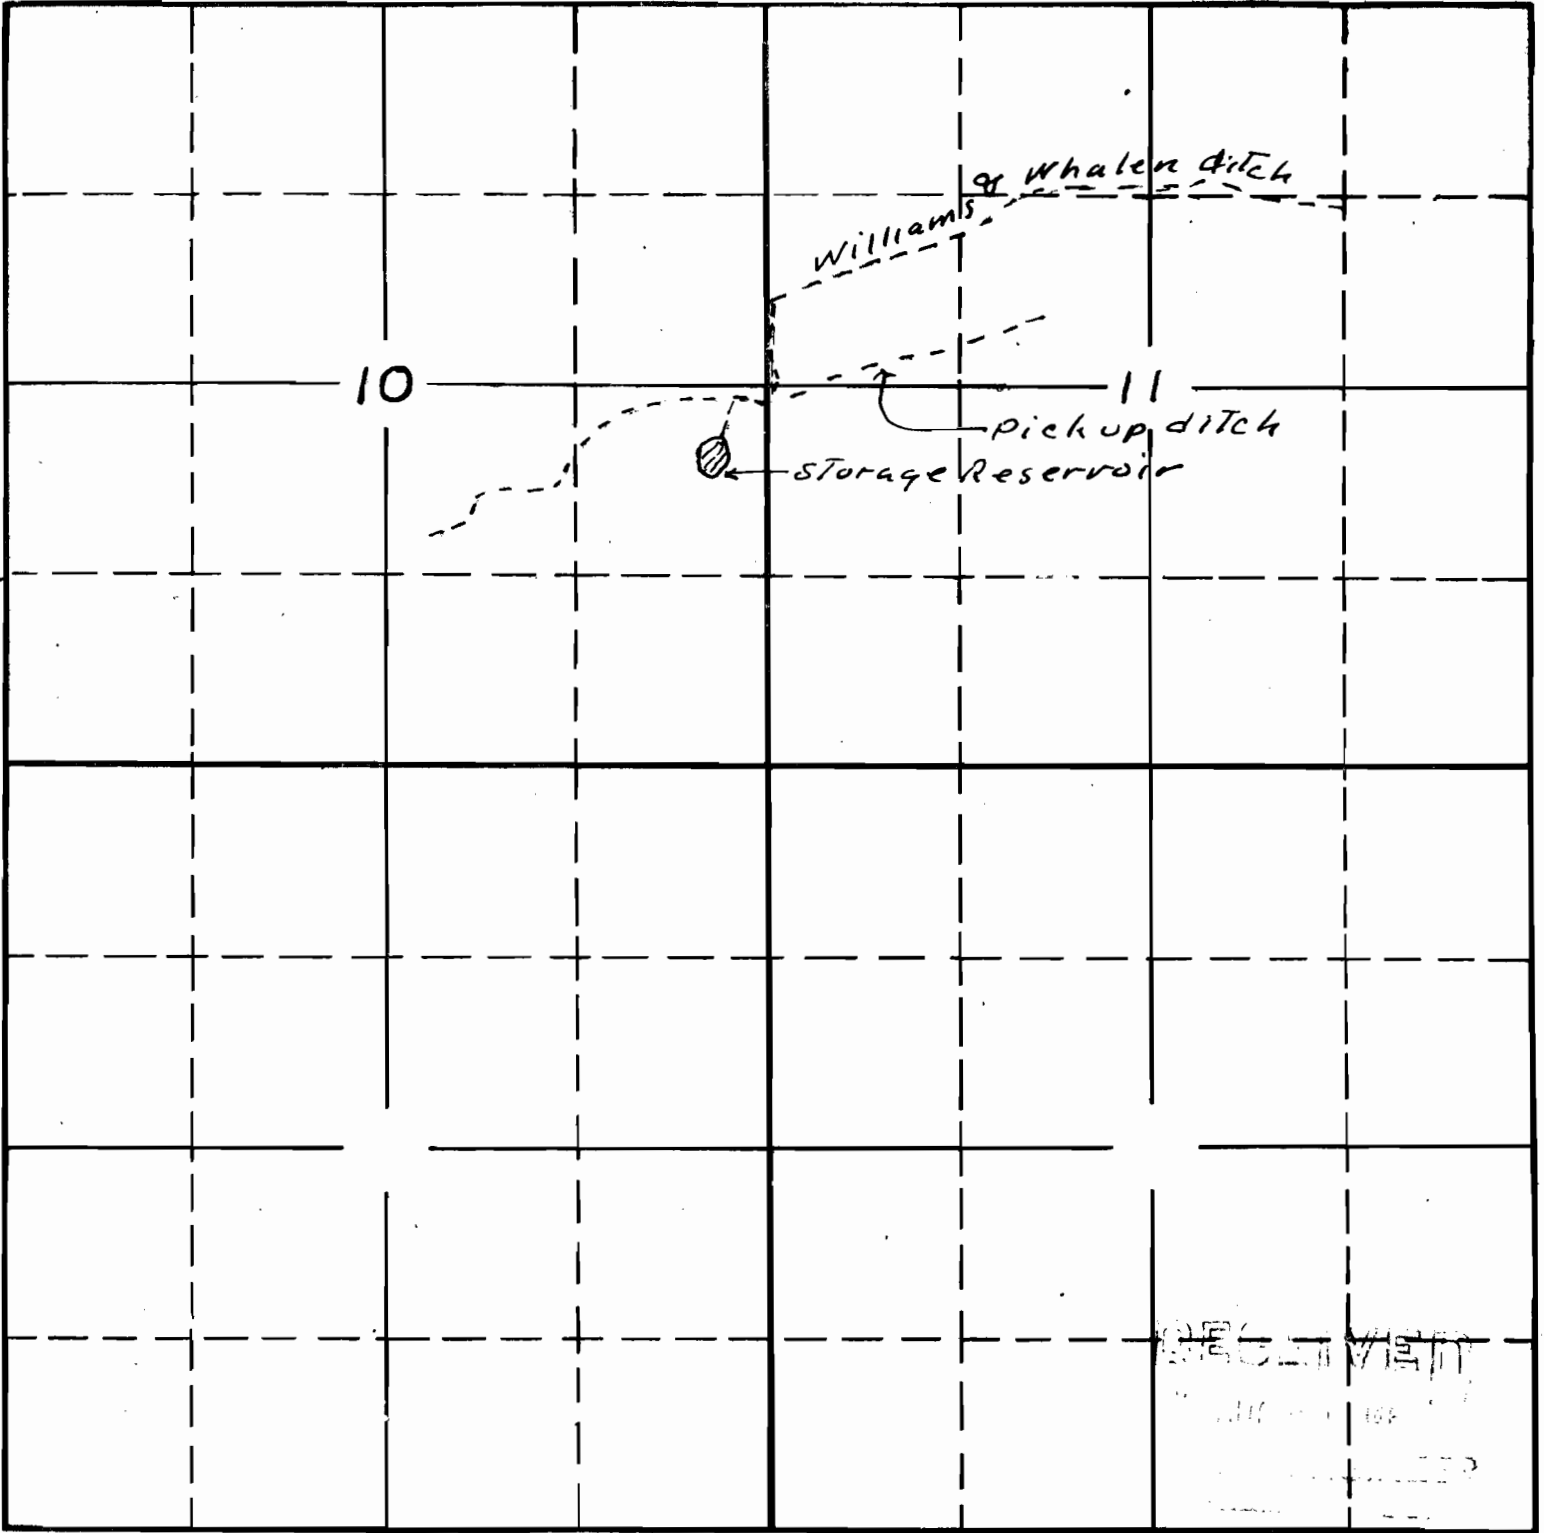

RECEIVED  
 JUN 10 1921  
 DIVISION OF WATER CONTROL

R-21921 21922 15-78E

South

Map to accompany application of  
 Ralph W Badcock for storage of  
 waste, seepage, runoff waters from  
 Williams & Whalen ditch also springs  
 within storage reservoir this office 5/27/46 W.B.

APPLICATION No. R-21921  
 PERMIT No. R-849