

RECEIVED

RECEIVED

FEB 11 1982


SEP 29 1981

WATER RESOURCES DEPT
SALEM, OREGON

WATER RESOURCES DEPT
SALEM, OREGON

Application No. R-62914
Permit No. R 8492

Application No. 63254
Permit No. 46977

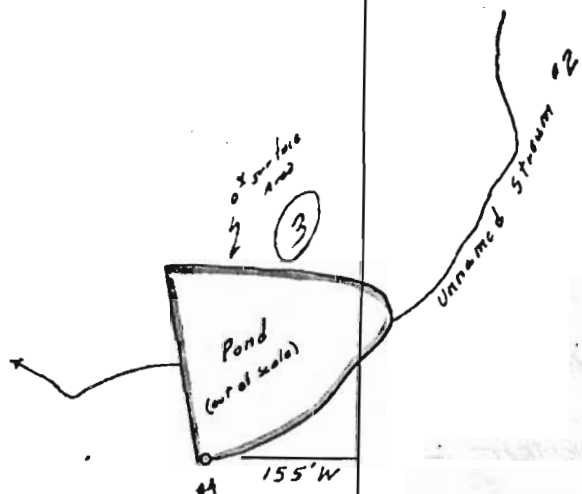

3910
R-6251

1190' W

1195' N

255' E

440' N

480' E

200' N

Application No. R-5001345
Permit No R 6251

3910

21 22

28 27 TOWNSHIP 26 SOUTH
RANGE 4 WEST