

SECTION

RECEIVED

SEP 14 1982

WATER RESOURCES DEPT.

SALEM, OREGON

TOWNSHIP 39S., RANGE 19E., W. M.


RECEIVED

JUL 21 1981

WATER RESOURCES DEPT

SALEM, OREGON

North

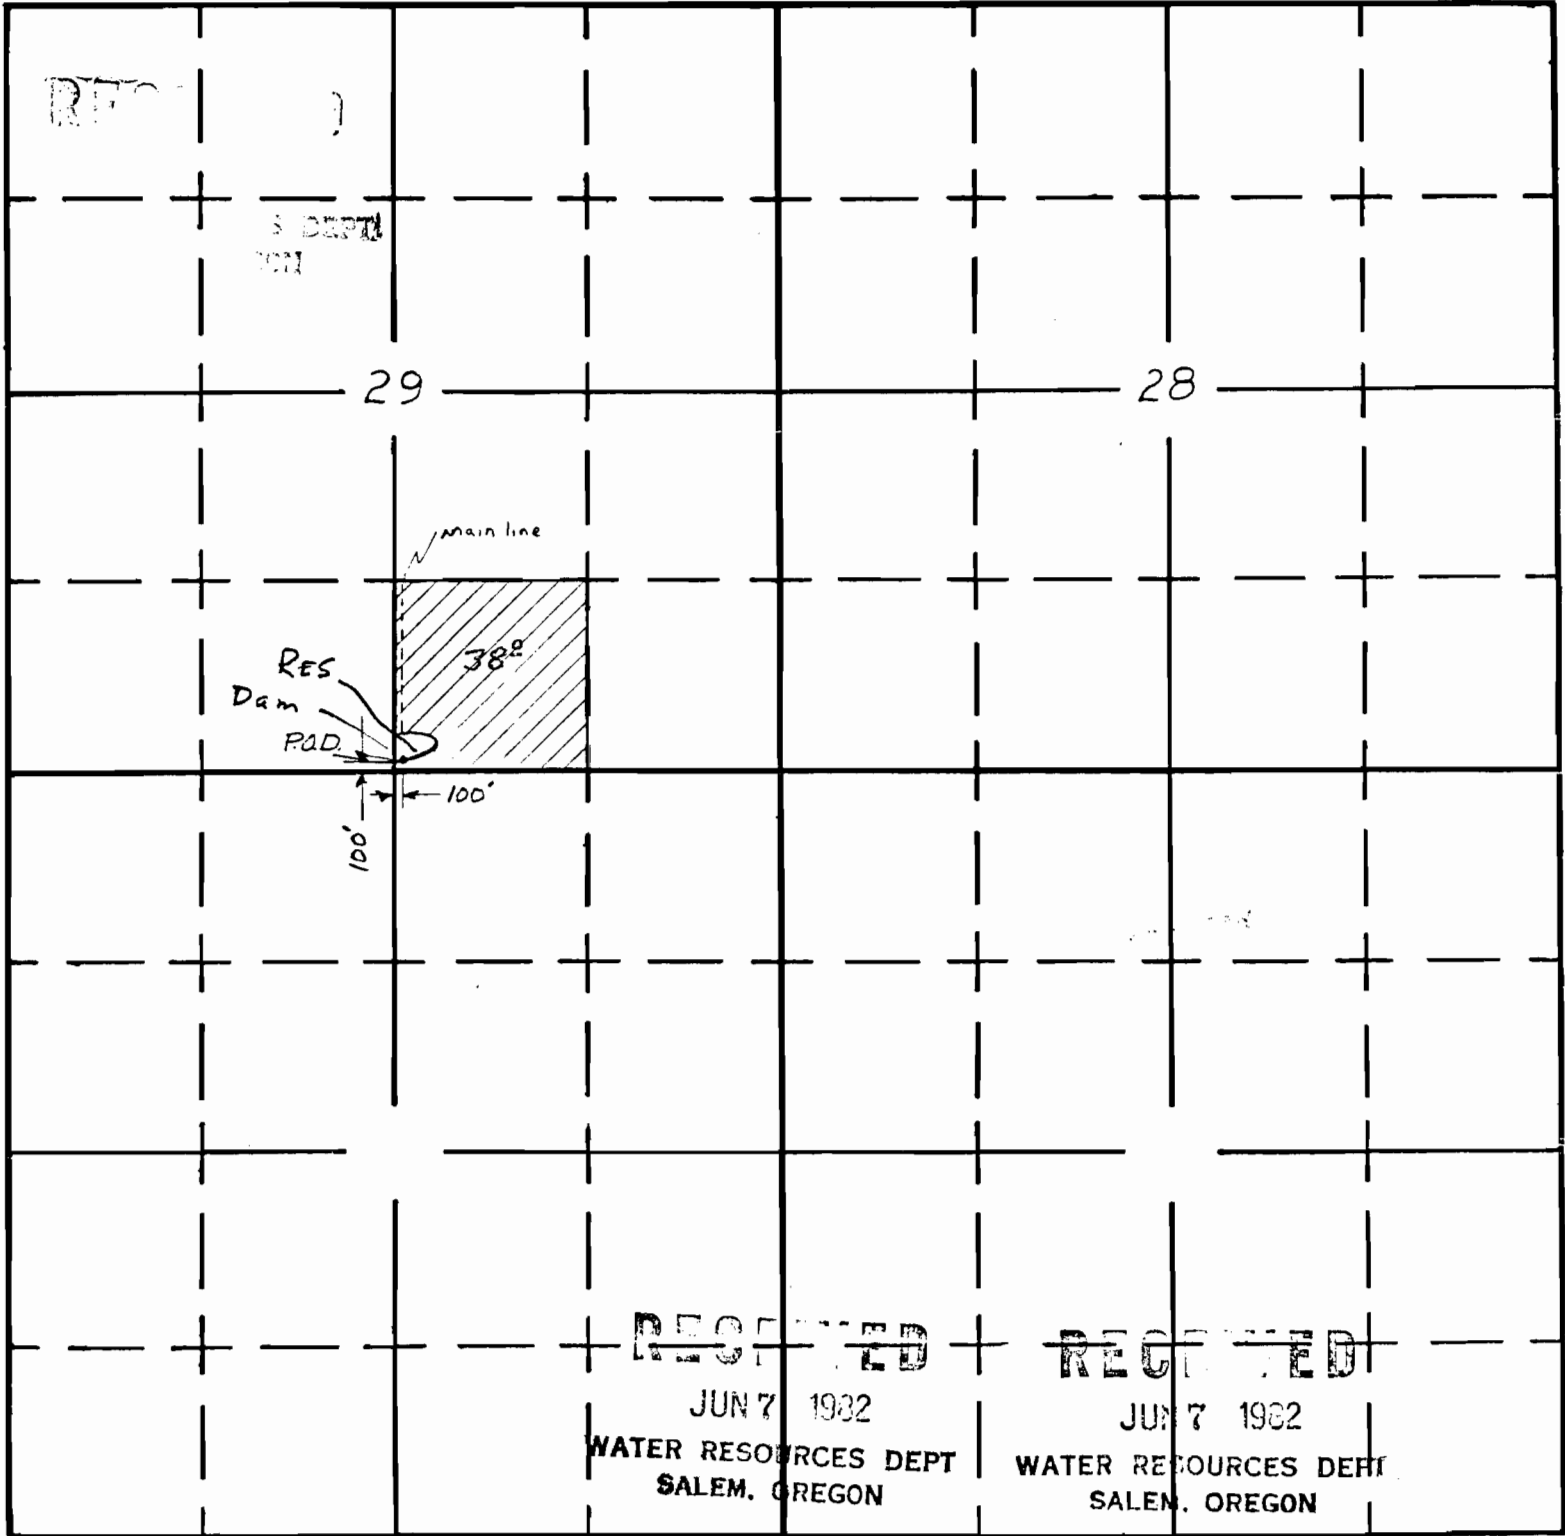

RECEIVED

JUN 7 1982

WATER RESOURCES DEPT  
SALEM, OREGON

RECEIVED

JUN 7 1982

WATER RESOURCES DEPT  
SALEM, OREGON

South

Scale - 4" = 1 mi

All information on this map furnished by applicant

Kevin Smith Kayle W. Smith  
Applicant

RECEIVED

NOV 25 1980

WATER RESOURCES DEPT

Application No. 61018 & R-6359  
Permit No. 47021 R 850