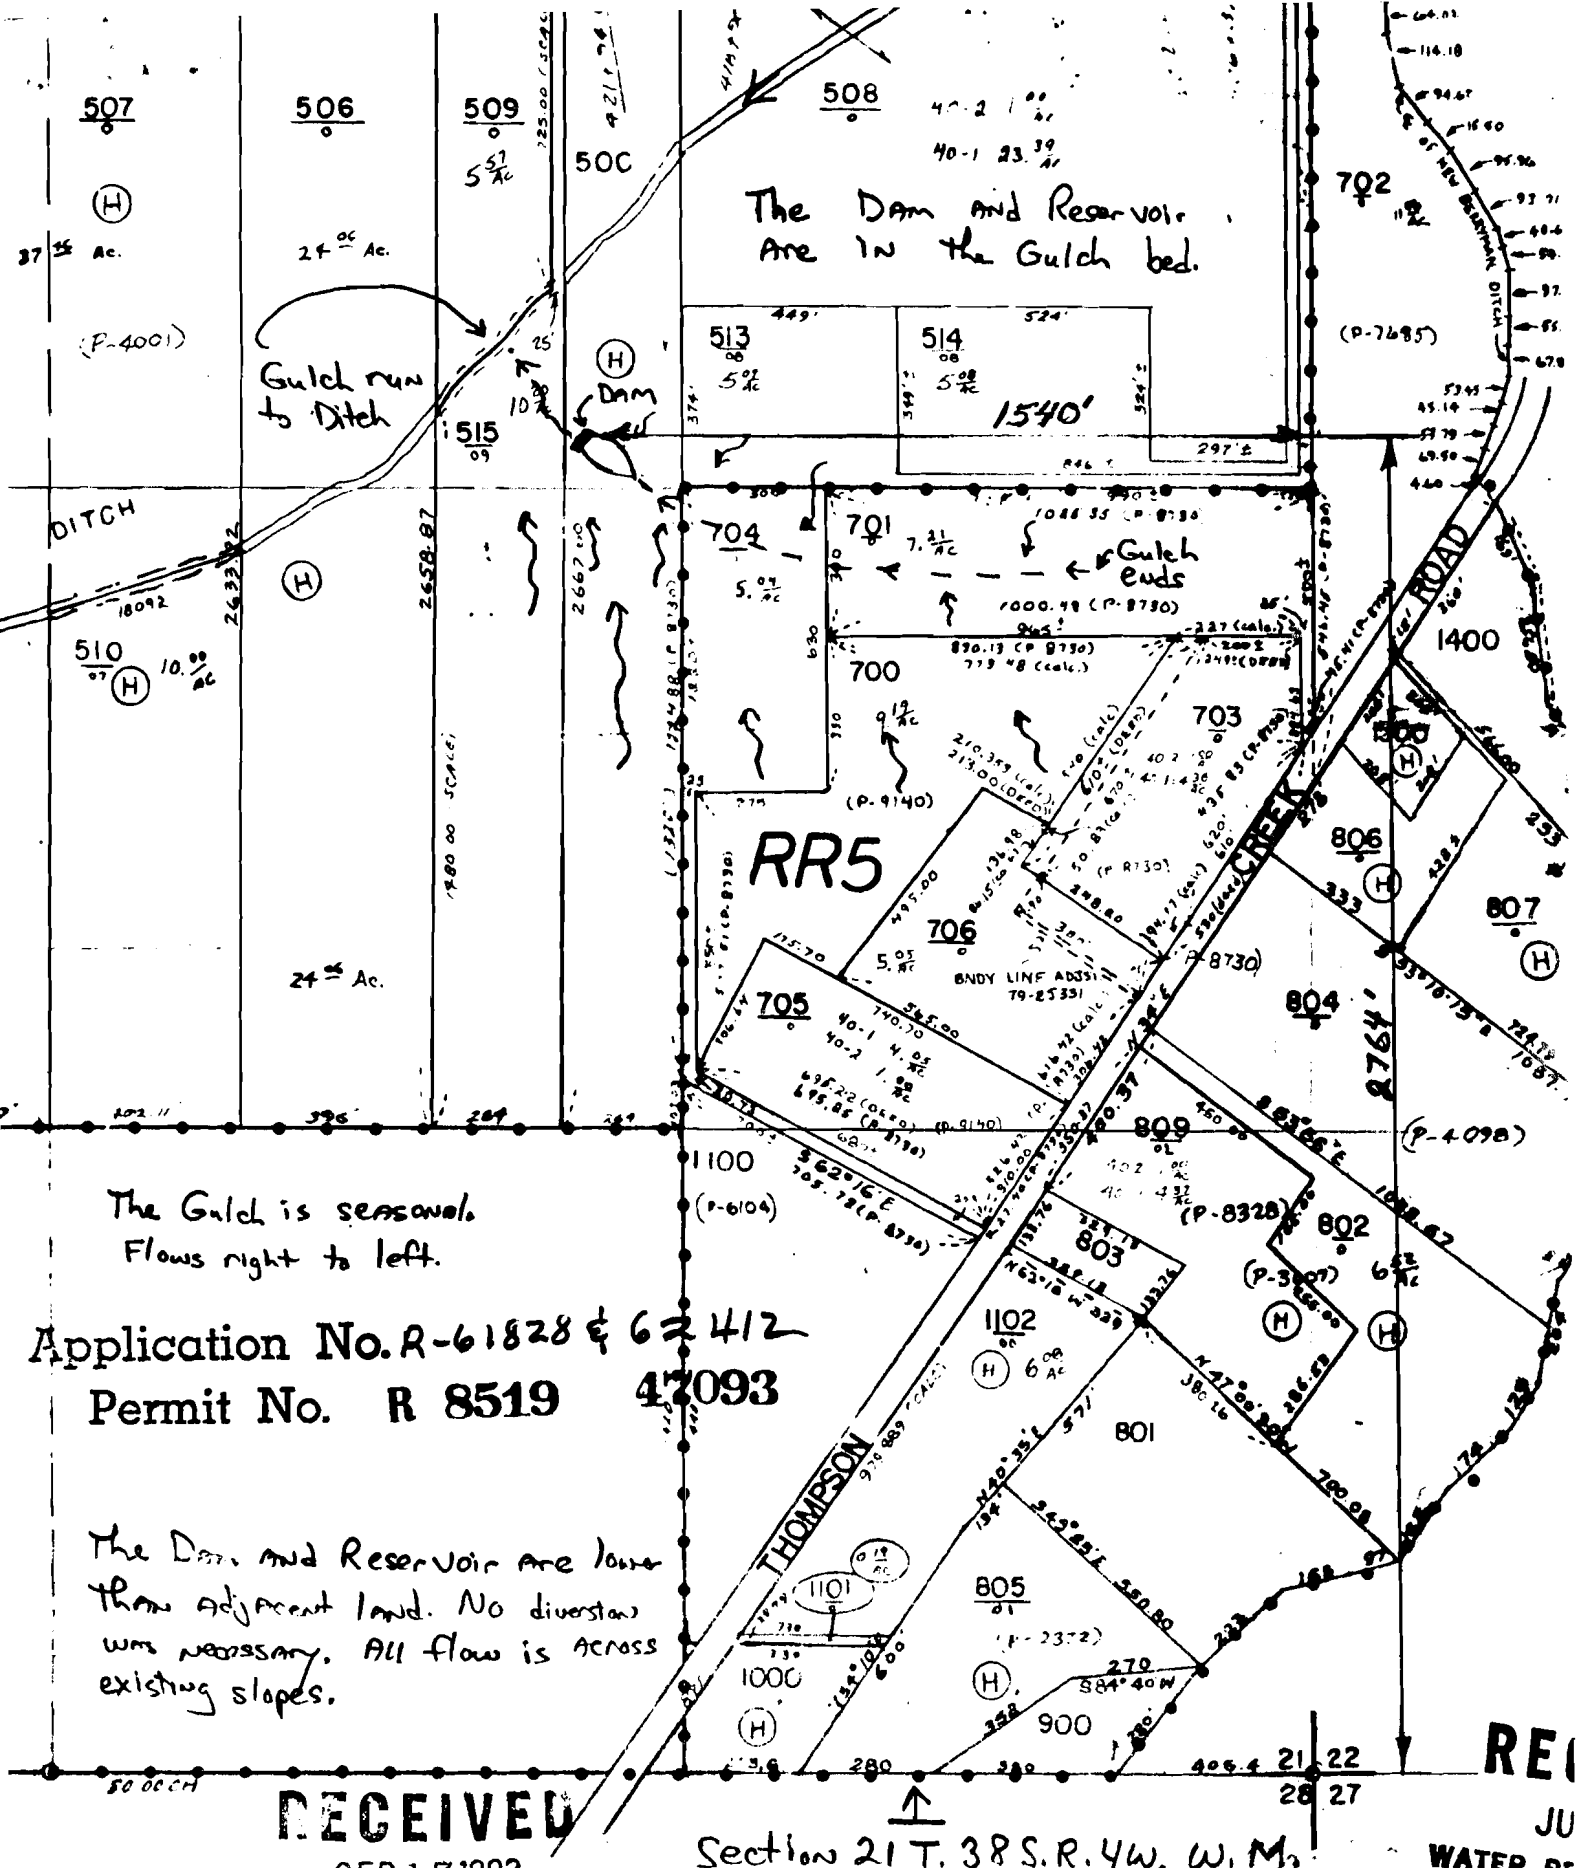
The Dam and Reservoir Are IN the Gulch bed.
Gulch run to Ditch
Dam
1540'
Gulch ends
RR5
DITCH
ROAD
CREEK
THOMPSON
2764'
The Gulch is seasonal. Flows right to left.
The Dam and Reservoir are lower than adjacent land. No diversion was necessary. All flow is across existing slopes.
Application No. R-61828 & 62412
Permit No. R 8519 47093
RECEIVED
SEP 17 1982
WATER RESOURCES DEPT.
SALEM, OREGON
Section 21 T. 38 S. R. 4W. W.M.
Scale 1" = 400'
4W 28
6/26/82, 9/15/82
CLB