


8

TOWNSHIP 36S, RANGE R3W, W. M.

North

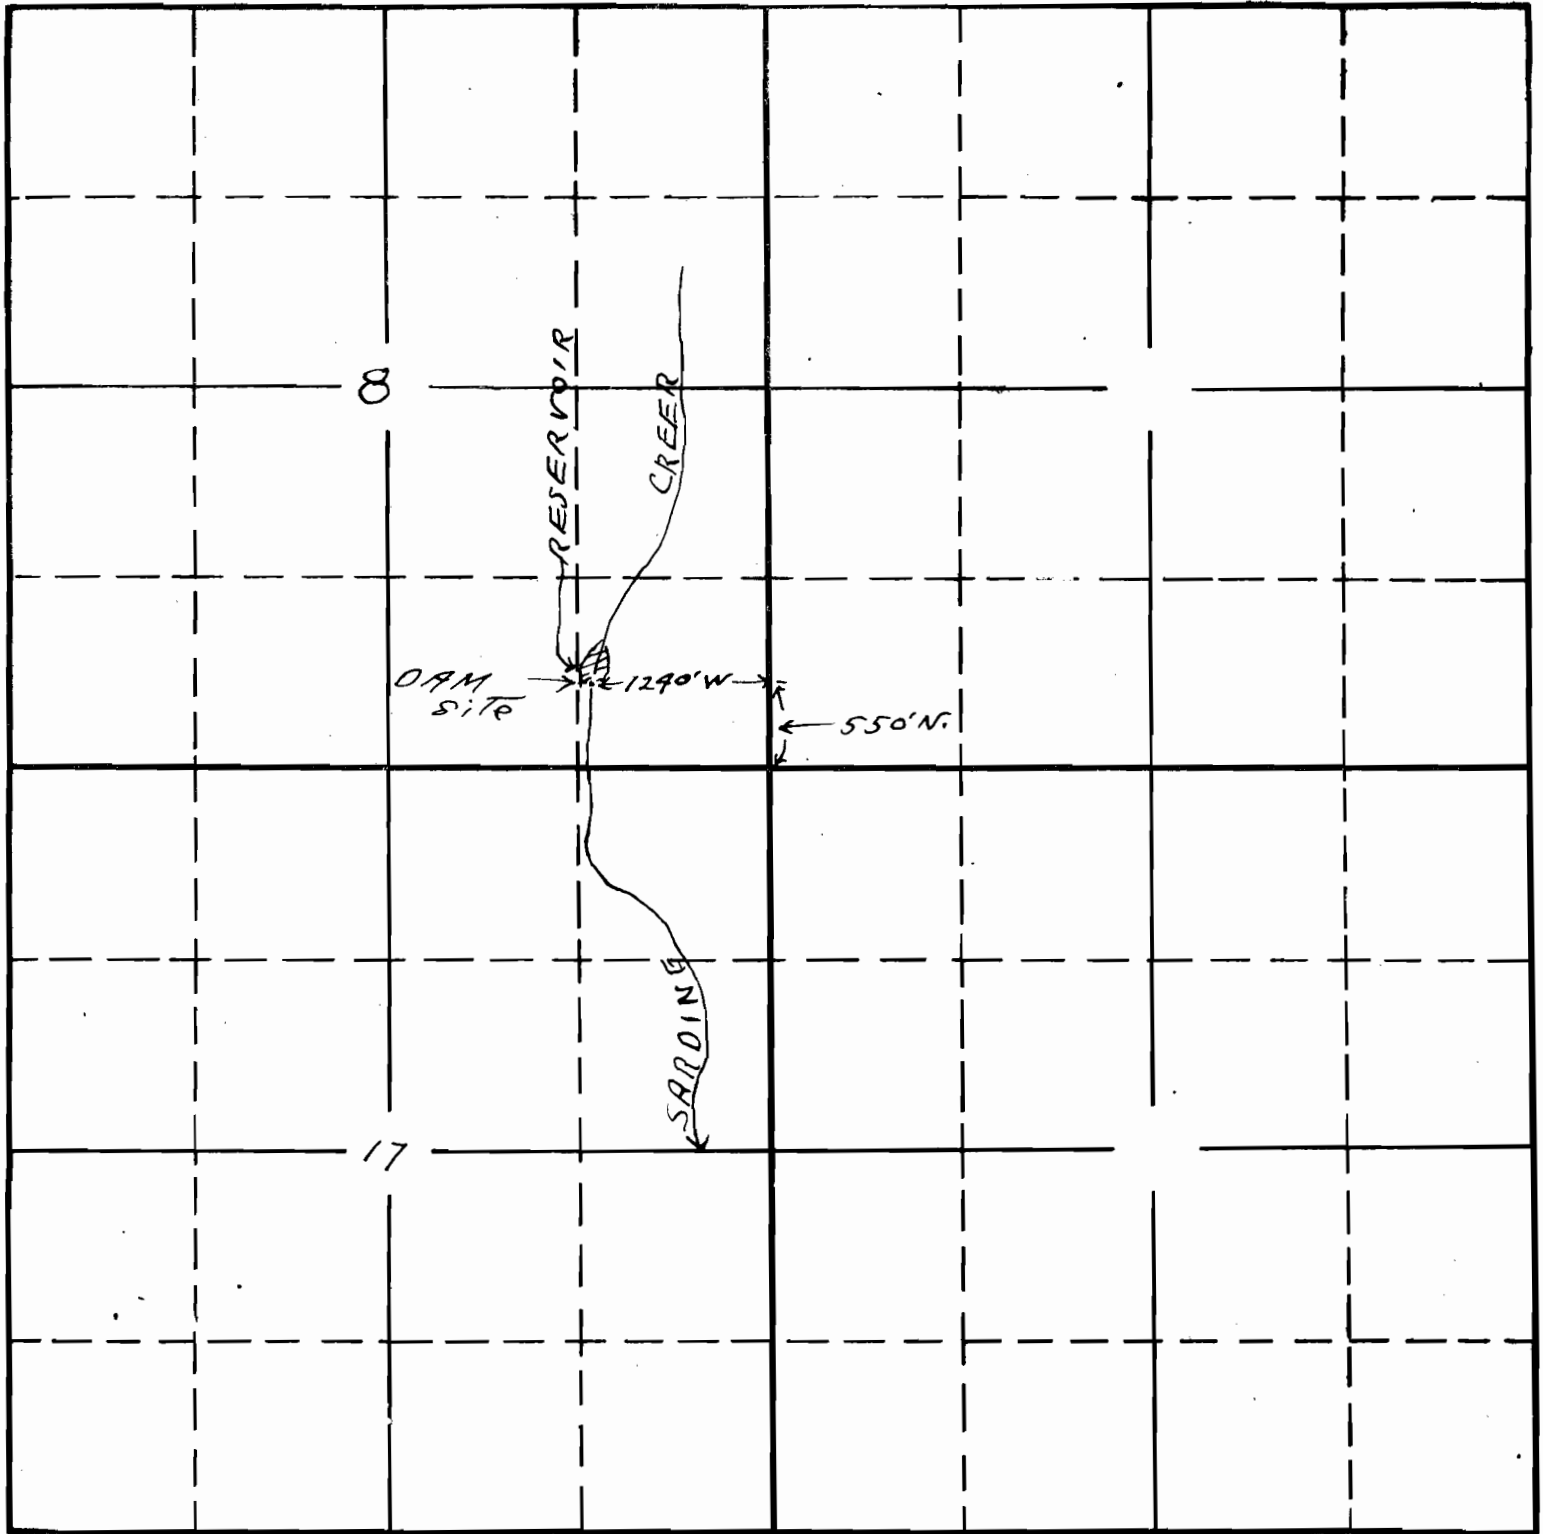

South

R-21996

15-78E

Map showing location of Foote  
 Reservoir for storage of waters from  
 Sardine Creek for irrigation purposes.

APPLICATION No. R-21996

PERMIT No. R-852

This office 9/26/46 *[Signature]*