


T. 36 S., R. 5 & 6 W., W. M.

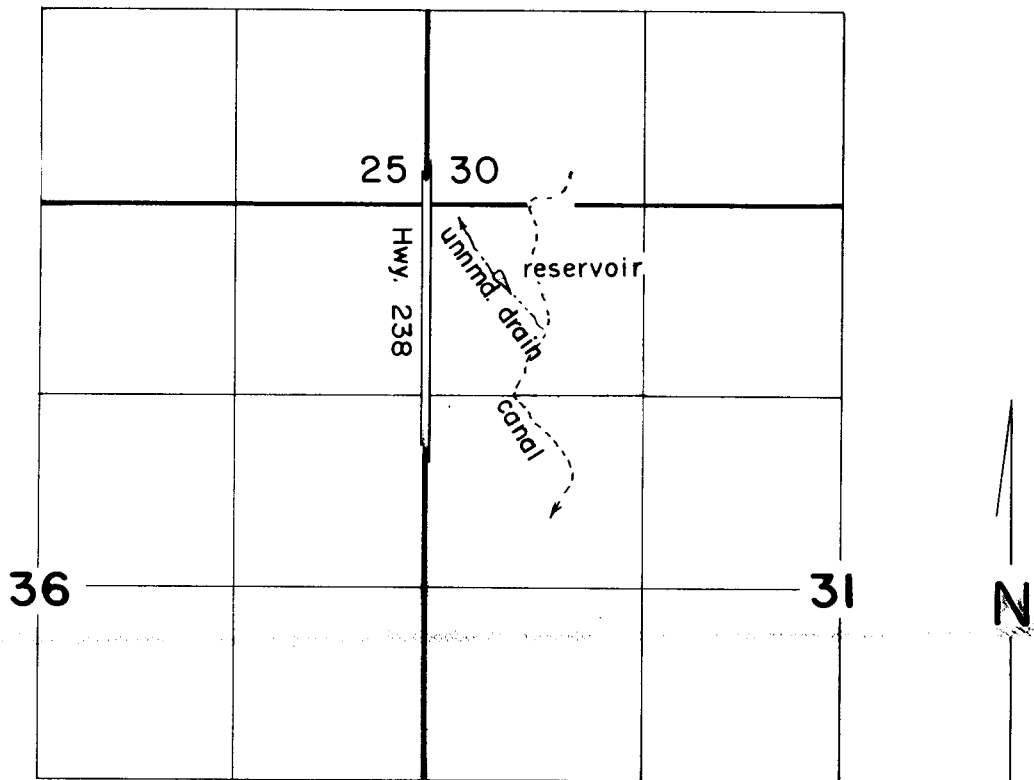

Scale: 1" = 1320'

RECEIVED

MAR 18 1991

WM. DIST. 14
GRANTS PASS, ORE.

FINAL PROOF SURVEY

UNDER

Application No. R-63696 Permit No. R-8523
IN NAME OF

GLEN F. RICHARDSON

Surveyed AUG. 25. 1988, by B. S. JAMES

B50-4-5 LMS
2/89