


SECTION

10

TOWNSHIP 38 S, RANGE 3 W, W. M.

North

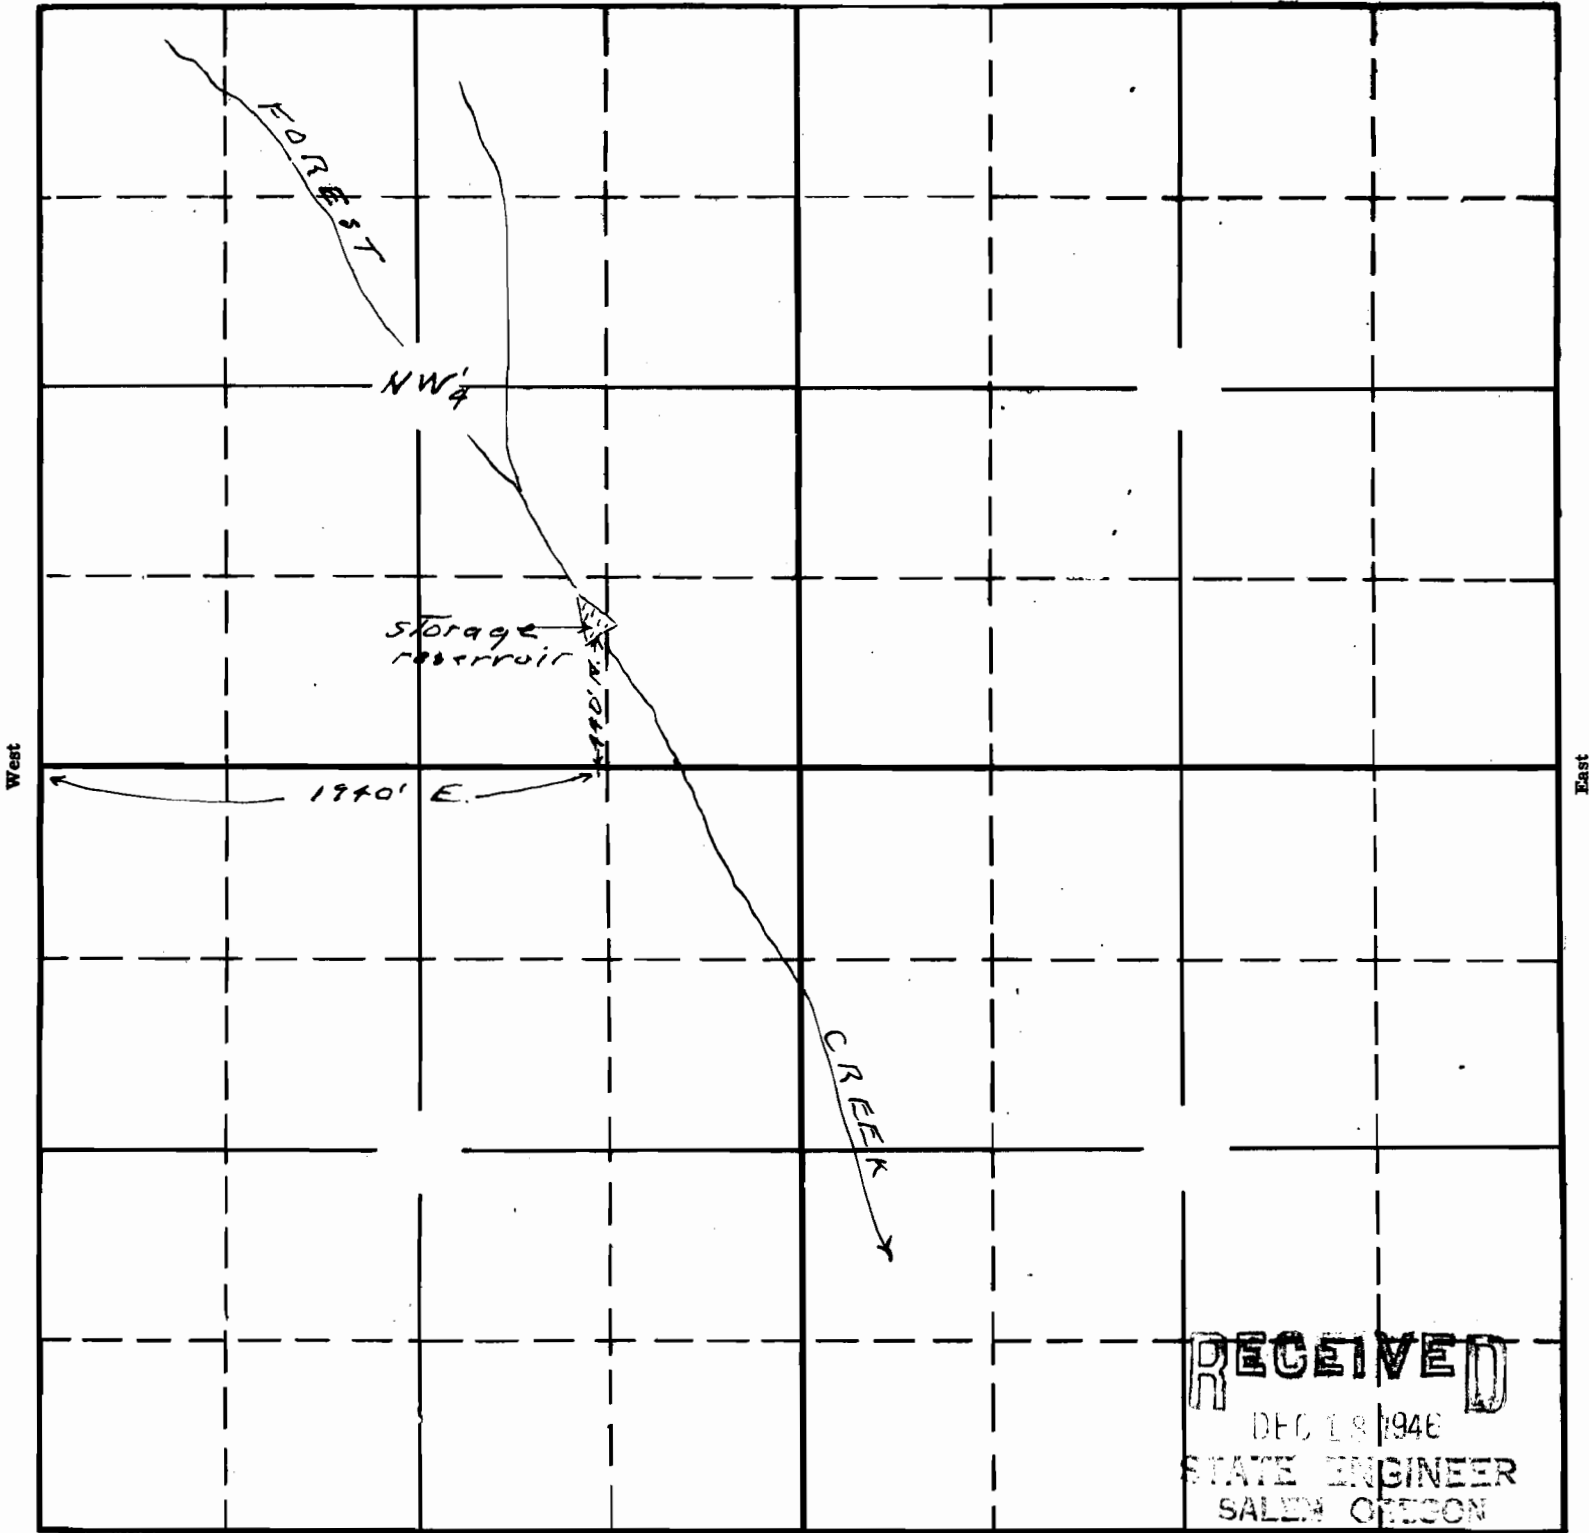

RECEIVED
 DEC 18 1946
 STATE ENGINEER
 SALEM OREGON

South

R-22143


15 16 0

Map To accompany application of
Mrs Gertrude Wittingham for
Storage purposes

APPLICATION No. R-22143

PERMIT No. R-830

This office 12/16/46 *Atkins*

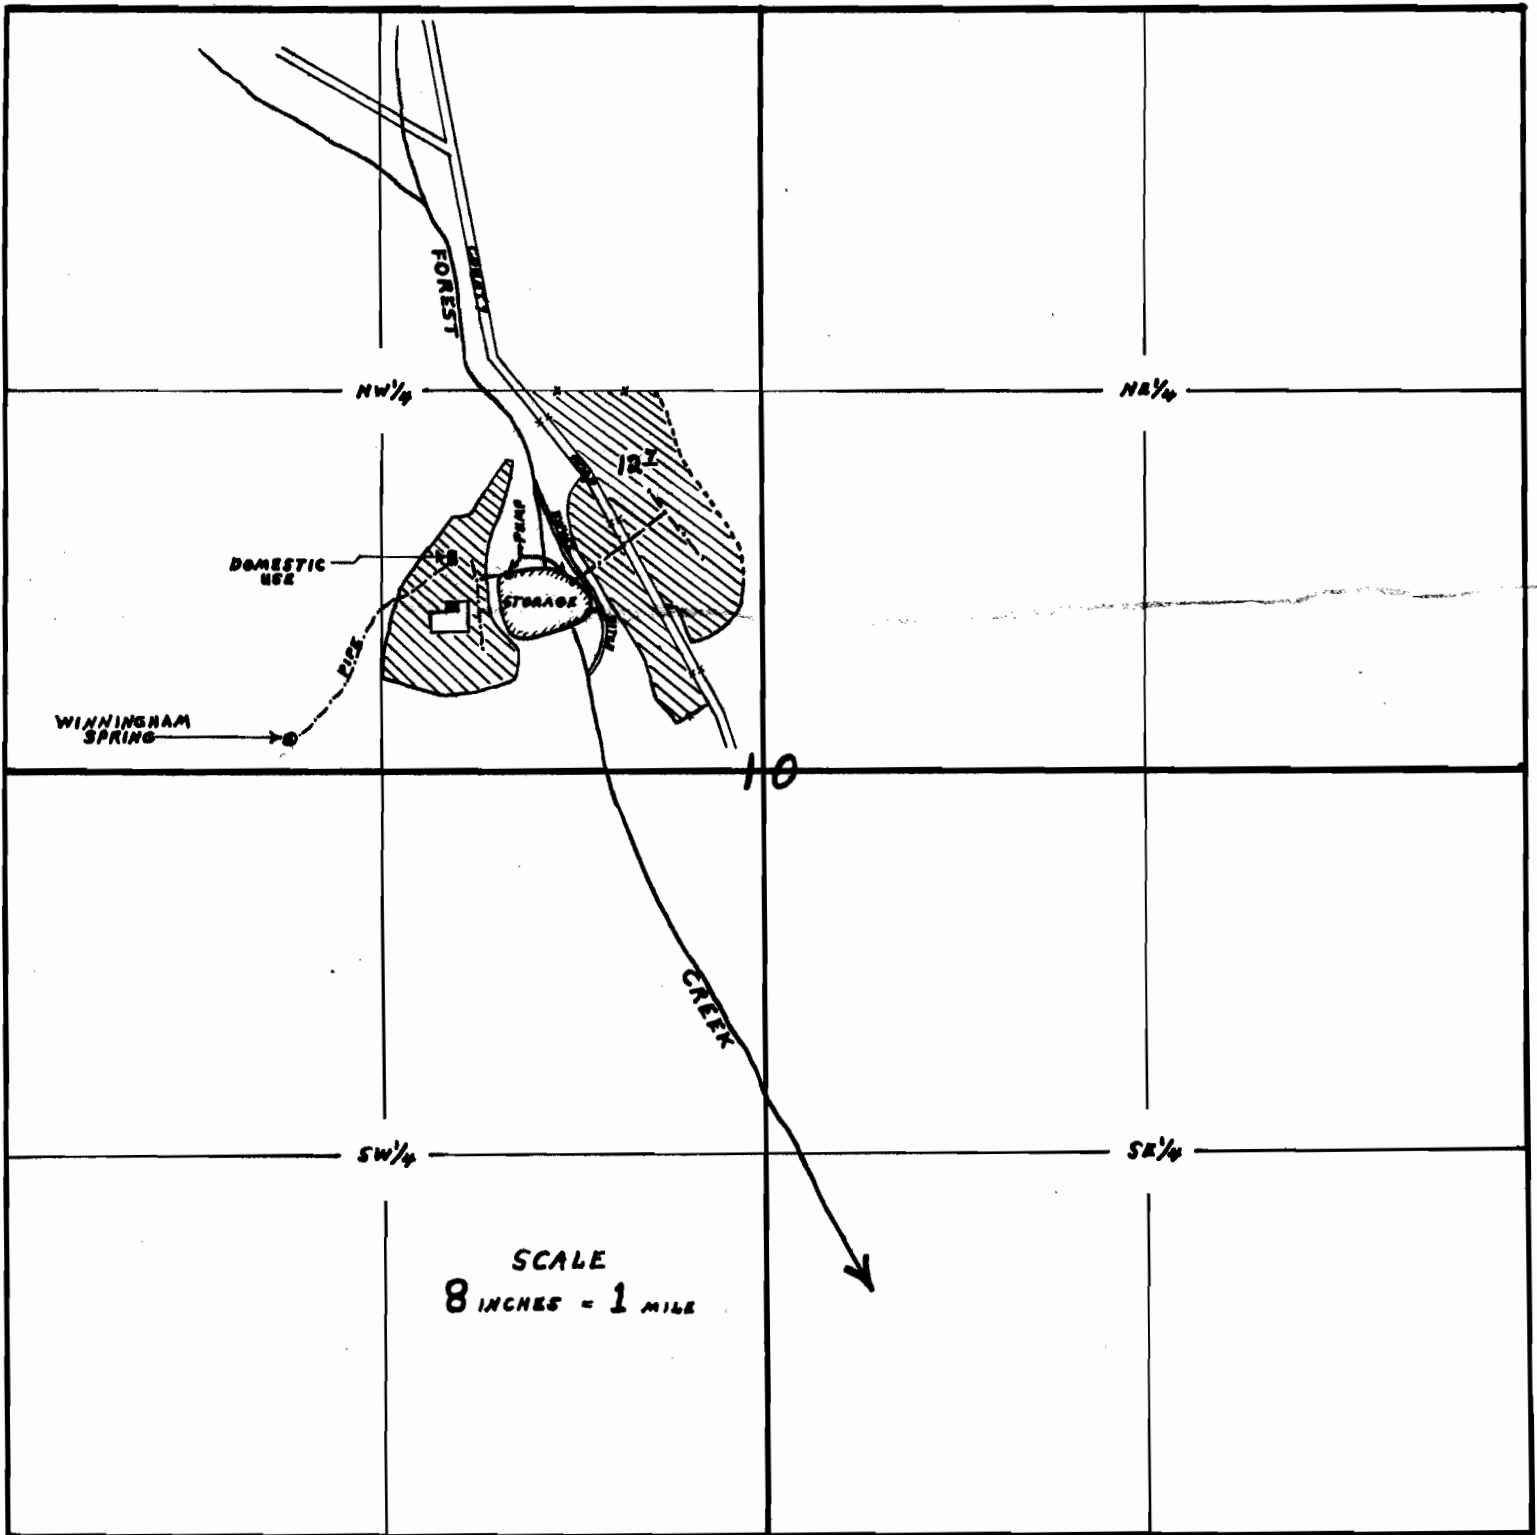

MAP ACCOMPANYING FINAL PROOF OF
MRS GERTRUDE WINNINGHAM, FOR USE OF WATER
FROM FOREST CREEK, WINNINGHAM SPRING AND
STORAGE FOR IRRIGATION AND DOMESTIC PURPOSES.

MAP COPIED FROM PLANE TABLE
SURVEY - MADE 11-17-54

David C. Hendrix
WATERMASTER DIST. NO. 15

RECEIVED
DEC 2 1954
STATE ENGINEER
SALEM, OREGON

APPLICATION No. R-22143
22144
PERMIT No. 17437
R-859