


SE1/4 SEC.6 T.26S. R.12W. W.M.
COOS COUNTY

26 12 6D

1"=200'

THIS MAP WAS PREPARED FOR
ASSESSMENT PURPOSE ONLY.

CANCELLED
1500
1701
1702
1801
1703
301
502
2001

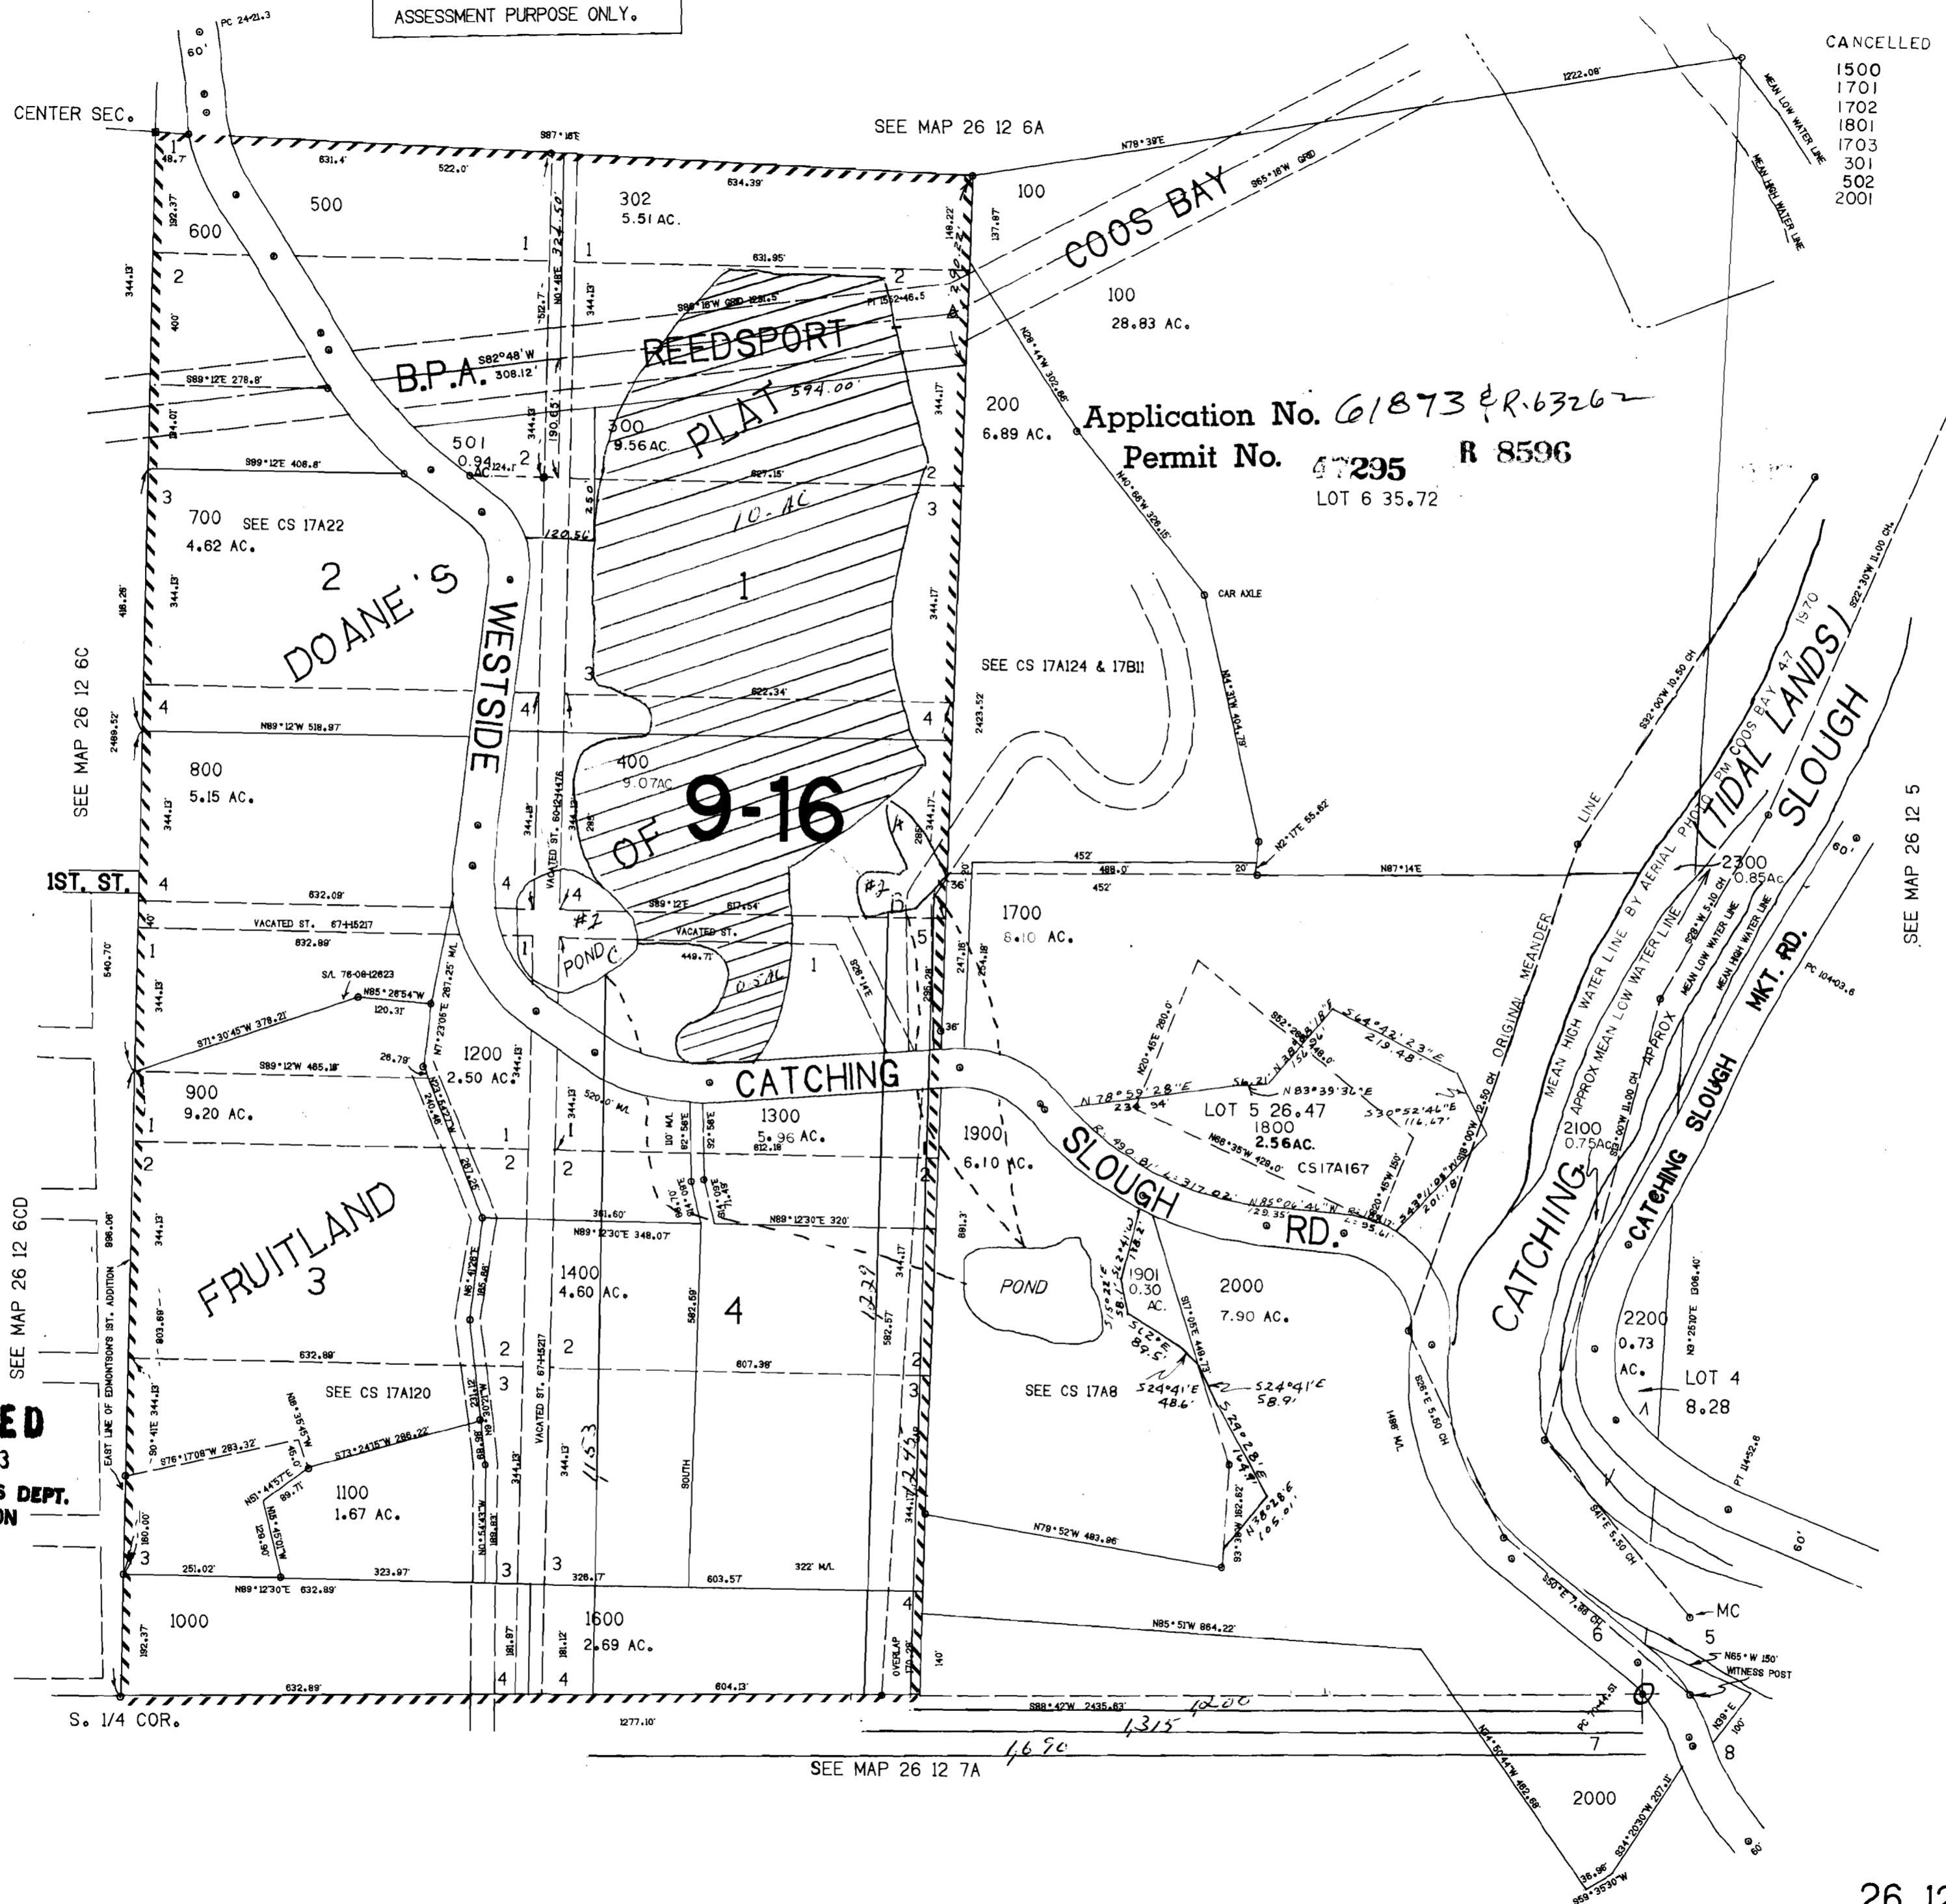

RECEIVED
JAN 21 1983
WATER RESOURCES DEPT.
SALEM, OREGON

CONTROL LAYOUT TRACED CHECKED

SEE MAP 26 12 7A

26 12 6D

1.026.000