


T. 265. R. 12 W.

RECEIVED

JUN 16 1981  
WATER RESOURCES DEPT.  
SALEM, OREGON

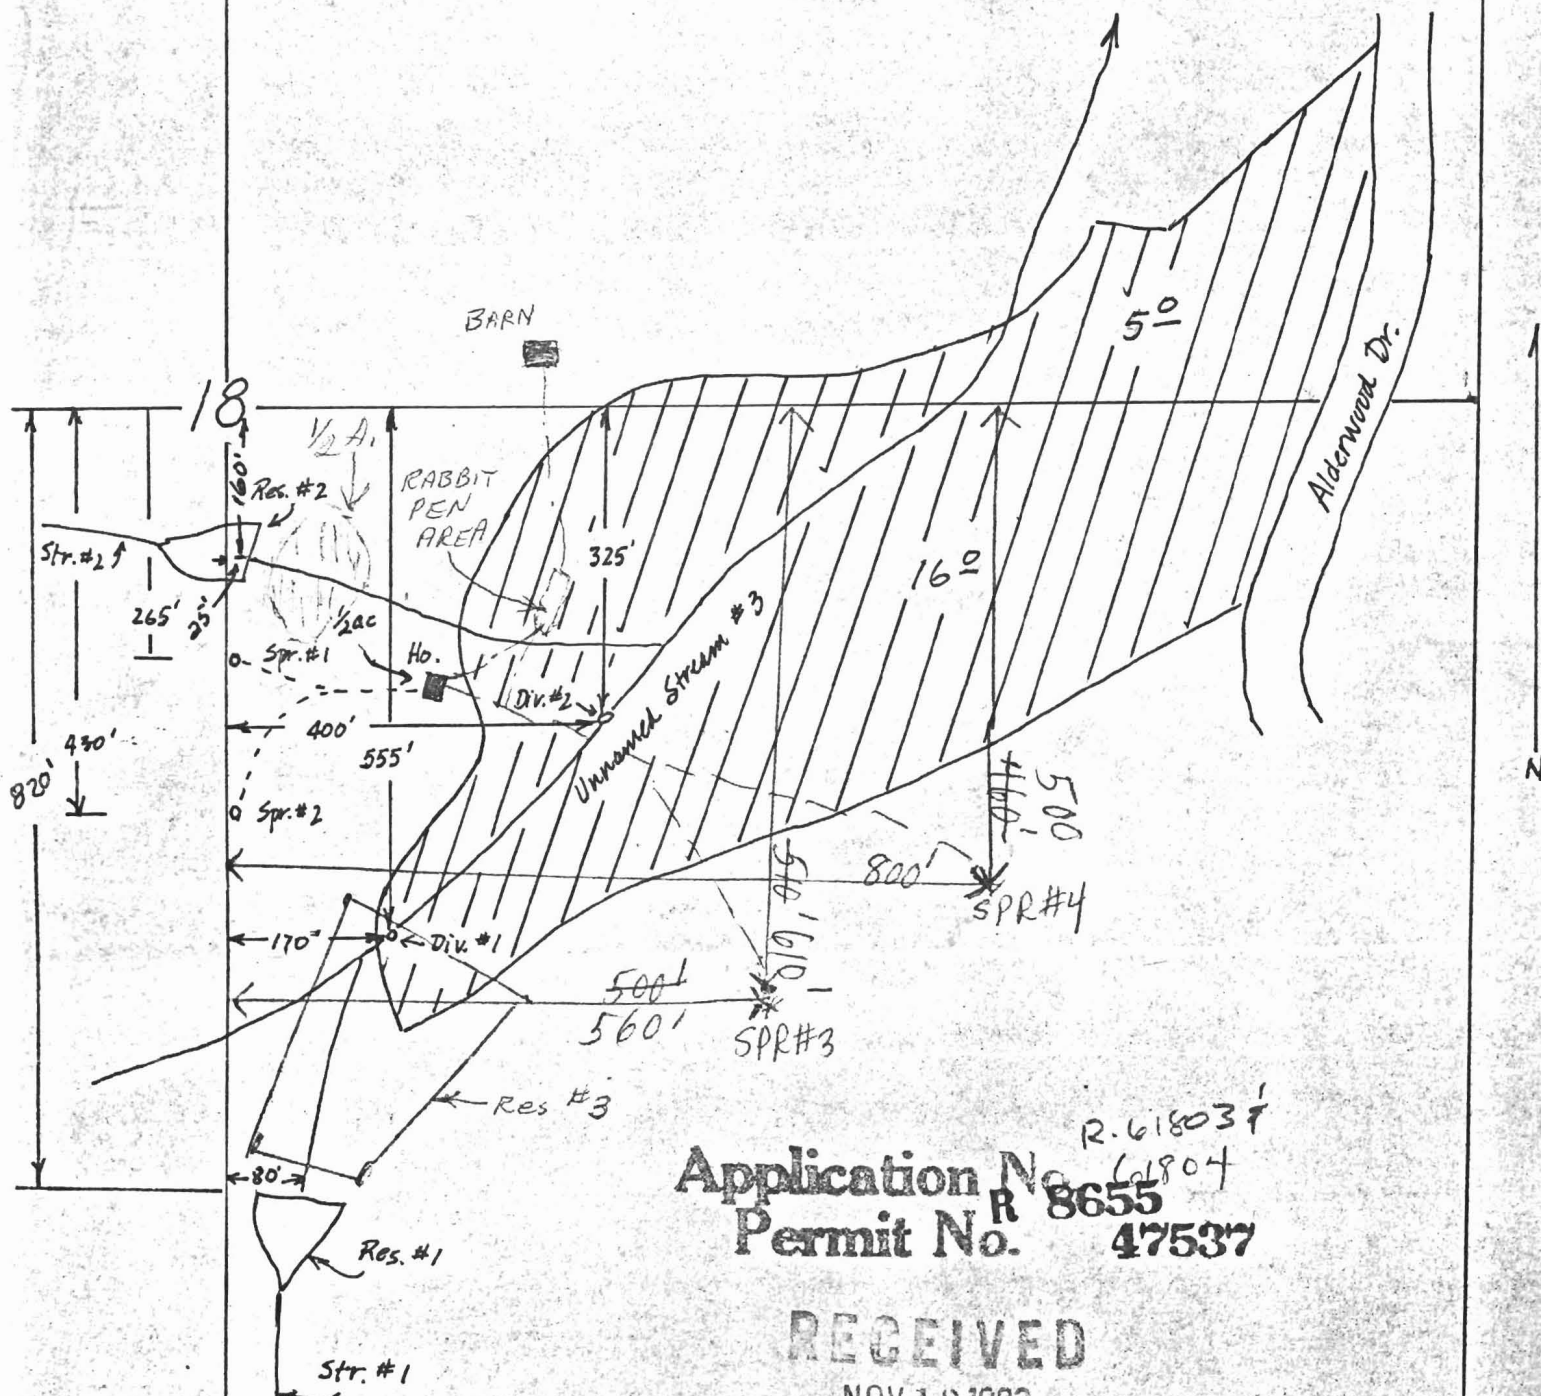

Application No. R. 61803 f  
Permit No. 8655  
61804  
47537

RECEIVED

NOV 12 1982  
WATER RESOURCES DEPT.  
SALEM, OREGON