T. 26S., R. 4W., W.M.

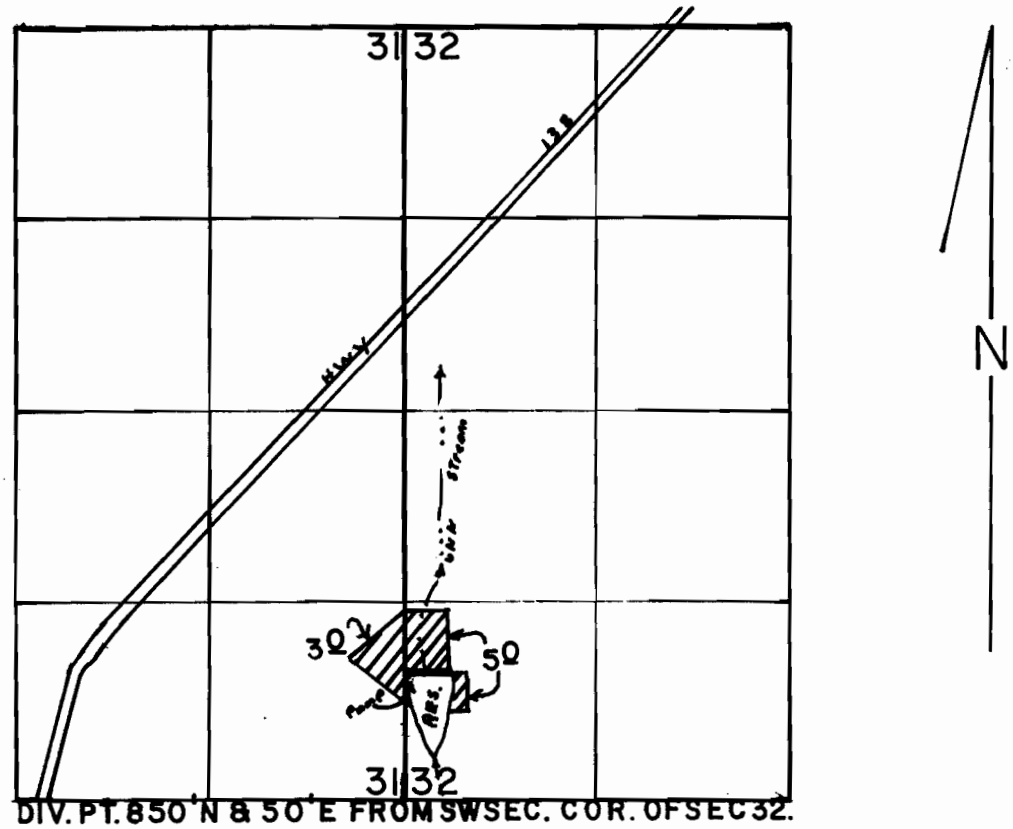

DIV. PT. 850' N & 50' E FROM SW SEC. COR. OF SEC 32.

SCALE: 1" = 1320'

FINAL PROOF SURVEY
UNDER

Application No. R-59217 (64543) Permit No. R-8665 (47456)

IN NAME OF

PETER B. SERAFIN

Surveyed JUNE 3, 1997, by R.M. SUTTERFIELD

7 1/2 QUAD 9/11/97 R.M.S.