


# T. 2 S., R. 3 E., W.M.

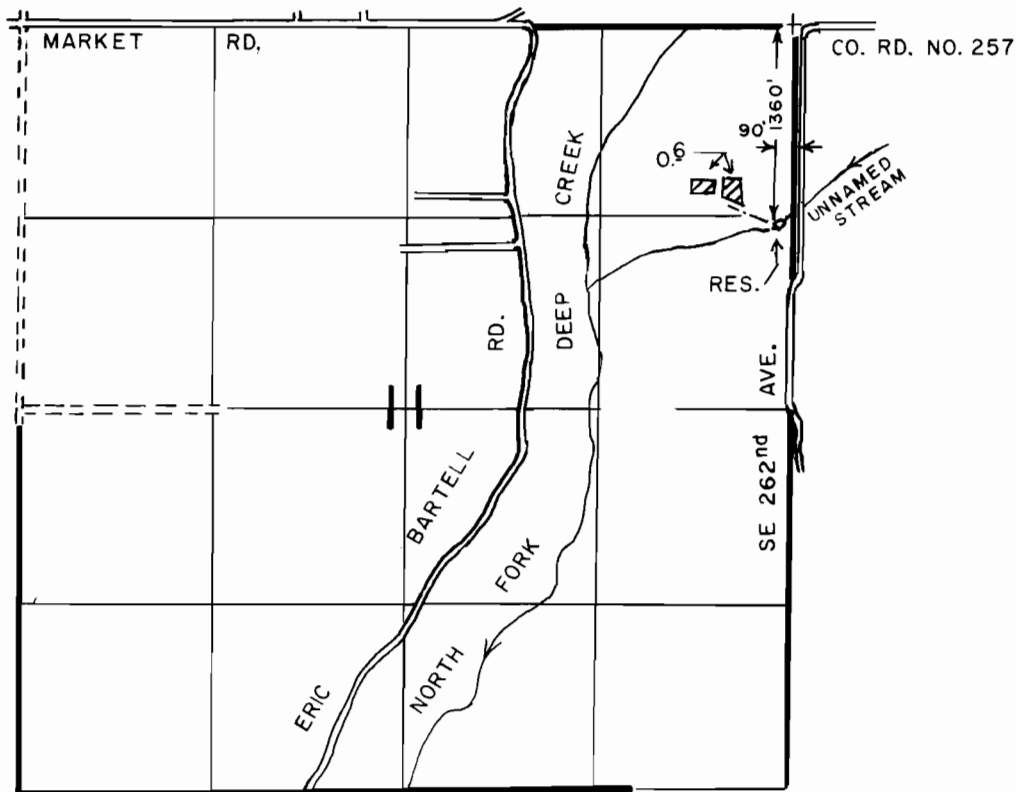

1" = 1320'

## FINAL PROOF SURVEY UNDER

R-64942                      R-8671  
Application No. 64943    Permit No. 47490.....  
IN NAME OF

..... JOHN    GRIFFIN .....

Surveyed MAY 17 1990, by T.M. WARREN .....