


Permit: R 8837
Volume: 6B
Strm: WASTEWATER/SEEPA
Trib: WILLIAMS CR
Priority: 7/05/83

T. 38 S., R. 5 W., W. M.

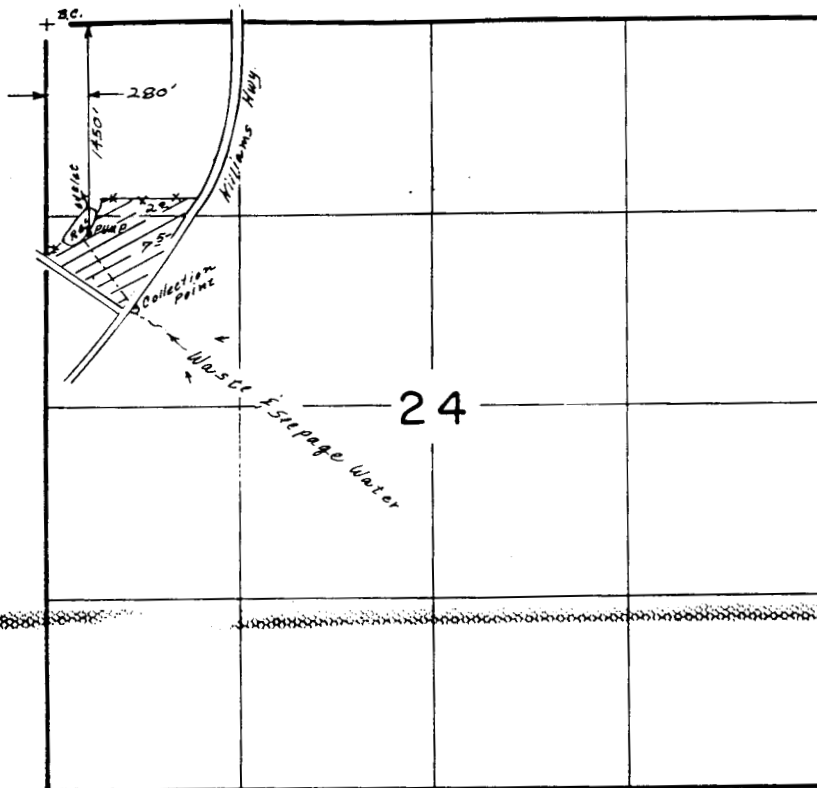

Scale: 1" = 1320'

RECEIVED

MAY 8 1991

WM. DIST. 14
GRANTS PASS, OREG

FINAL PROOF SURVEY
UNDER

Application No. R-65266 Permit No. R-8837
64167 47765
IN NAME OF

JAMES C. & EDITH L. KEDING

Surveyed AUG...8... 19.88, by B...S...JAMES....